10:00 Robert Irby (CI) 203966

IREDELL COUNTY HEALTH DEPARTMENT

STATESVILLE 704-878-5305 MOORESVILLE 704-664-5281

IMPROVEMENT PERMIT / AUTHORIZATION TO CONSTRUCT / OPERATION PERMIT / EXISTING SYSTEM INSPECTION

PERMIT# 35888 PIN# 4722 57 3570 DATE 6-15-06

OWNER OR APPLICANT ROBERT D & DANIEL L Irby PHONE: Business 704-528-4840 Home 704-252-1007

ADDRESS 157 Purple Hill Dr Statesville, NC 28677

LOCATION Buffalo Shoals Rd (R) Old Mtn Rd (R) Purple Hill Bottom at hill on LEFT.

SUBDIVISION Lippard Springs BLOCK / SECTION III LOT 39 LOT AREA 0.964 SITE CLASS. PS DESIGN FLOW 360 L.T.A.R. 1.5

Septic Tank: 1000 Gallons: STB 1012 Date 10-23-06
Pump Tank: 1000 Gallons: PT 17 Date 3-10-07
Pump Make: Gould's Model WED 312MV Serial No. ~~00-76-7406~~
Nitrification Field: No Fields 1 Square Feet 1120 Linear Feet 380'
No Lines 3x100' Trench Width 36" Max Trench Bottom Depth 36"

☒ New System ☐ Repair ☐ Expansion System Type: I II III IV V VI
System Description: Pump 25% Reduction
Repair System Description: LP 50% Reduction
Maintenance Agreement Required: ☐ Yes ☒ No
Gravel Depth N/A ☐ Gravity ☒ Pressure

☒ House/Mod. Home ☐ Mobile Home ☐ Business ☐ Other
No. Bedrooms 3 No. Persons 6 No. Employees

Water Supply: ☒ Individual ☐ Public ☐ Community


☐ Slab ☐ Crawl Space ☒ Basement w/plumbing ☐ Basement wo/plumbing

Comments:/Conditions: (1) EXPLAINED ALL SETBACKS WITH OWNER & BUILDER DUE TO Complexity OF THE LOT (2) INSTALL LINES ON CONTOURS (3) MAINTAIN SETBACKS


Comments:/Conditions: TUFF TITE F. Wtr & MOISTURE

NO BASEMENT PLUMBING

INITIAL SITE SKETCH

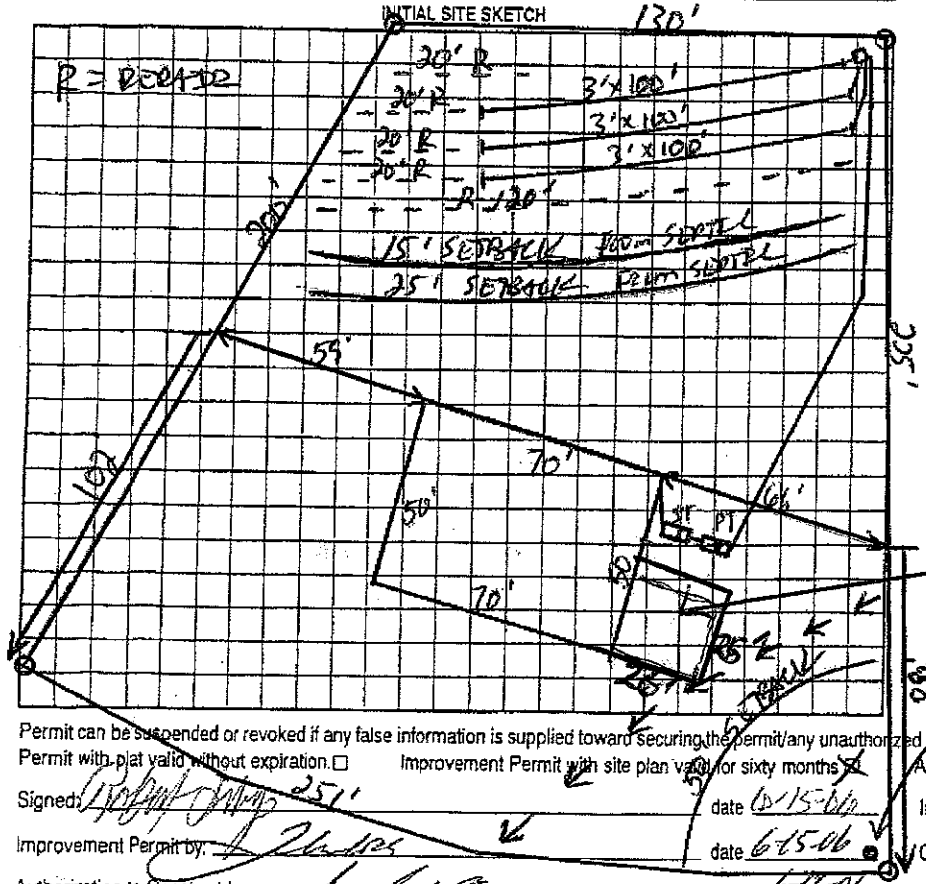

AS BUILT SKETCH

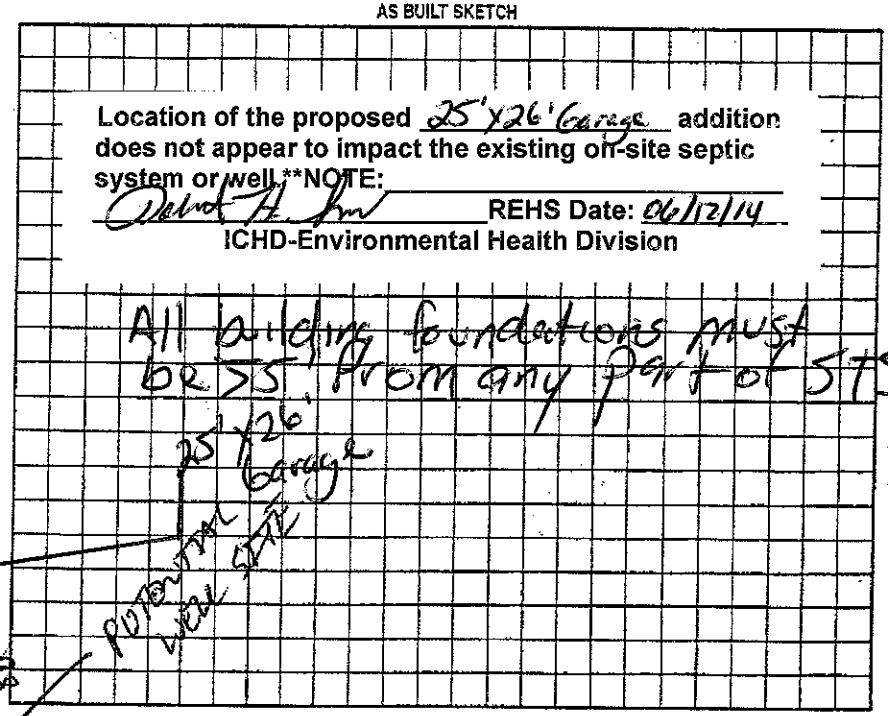

Permit can be suspended or revoked if any false information is supplied toward securing the permit/any unauthorized changes are made to the site/any unauthorized changes are made in the installation of the system. Improvement Permit with plat valid without expiration. ☐ Improvement Permit with site plan valid for sixty months ☒ Improvement Authorization to Construct is valid for a period equal to that of Improvement Permit – not to exceed sixty months.

Signed: [signature] date 6/15/06 Installed by: Steve Jordan

Improvement Permit by: [signature] date 6-15-06 Operation Permit by: [signature] date 5-30-07

Authorization to Construct by: [signature] date 6-15-06 Existing System Inspection by: _____ date _____

HEALTH DEPT. COPY: WHITE OWNER COPY (FINAL): YELLOW OWNER COPY (INITIAL): PINK