IREDELL COUNTY HEALTH DEPARTMENT

STATESVILLE 704-878-5305 MOORESVILLE 704-664-5281

IMPROVEMENT PERMIT / AUTHORIZATION TO CONSTRUCT / OPERATION PERMIT / EXISTING SYSTEM INSPECTION

PERMIT# 072890 PIN# 4722 57 5036 DATE 4-21-98

OWNER OR CONTRACTOR CCS, INC PHONE: Business Home 924-8635

ADDRESS 318 W. BROAD ST, SUITE 2, STATESVILLE, NC 28677

LOCATION I-40 W TL OLD MTN. ROAD, TL RUMPLE HILL, TR ST. MARTINS LANE, 1ST LOT ON LEFT

SUBDIVISION LIPPARD SPRINGS BLOCK / SECTION 1 LOT 31 LOT AREA 0.64 ACRE SITE CLASS. PS DESIGN FLOW 360 L.T.A.R. 0.30 GPD/FT

Septic Tank: 1000 Gallons; STB 625 Date 6-3-98
Pump Tank: Gallons; PT Date
Pump Make: Model Serial No.
Nitrification Field: No Fields 1 Square Feet 1200 Linear Feet 400
No Lines FIVE Trench Width 36" Max Trench Bottom Depth 30" Gravel Depth 12"

☑ New System ☐ Repair System Type: I (II) III, IV, V, VI
System Description: CONVENTIONAL GRAVITY
Repair System Description: PPBPS GRAVITY
Maintenance Agreement Required: ☐ Yes ☑ No

☑ House/Mod. Home No. Bedrooms 3
☐ Mobile Home No. Bathrooms 2
☐ Business No. Employees
☐ Other
☐ Slab ☑ Crawl Space ☐ Basement w/plumbing ☐ Basement wo/plumbing


Water Supply: ☑ Individual ☐ Public ☐ Community WELL

Comments:/Conditions: KEEP SYSTEM MINIMUM 100 FEET FROM WELLS!

SCALE: 1" = 40'

Comments:/Conditions:

INITIAL SITE SKETCH

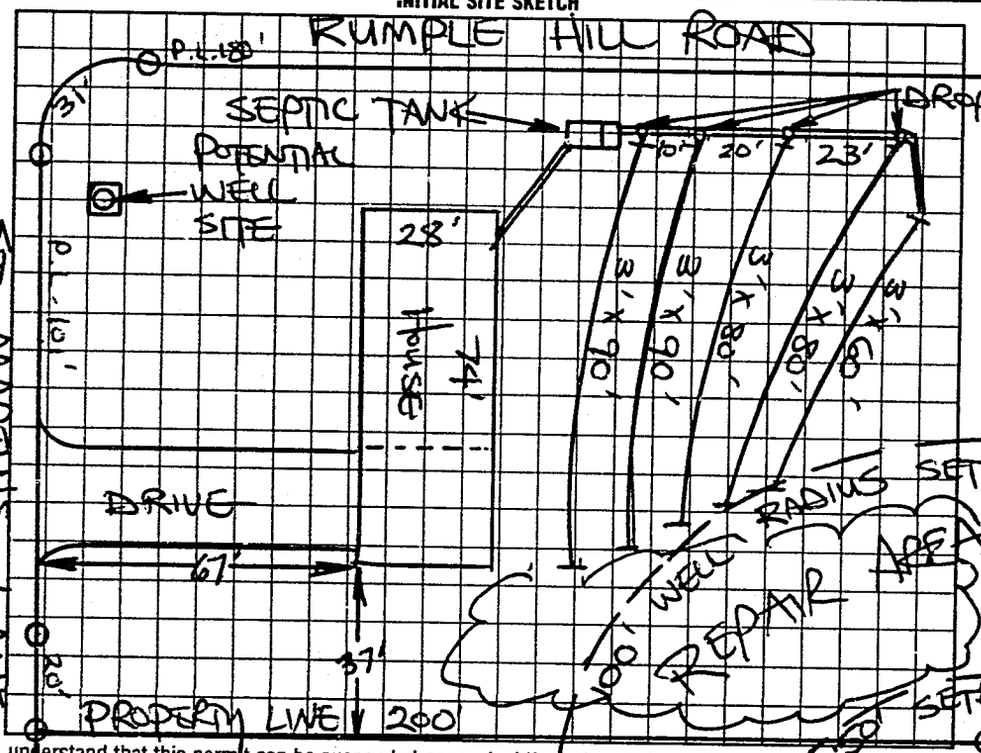

AS BUILT SKETCH

Same as initial sketch

I understand that this permit can be suspended or revoked if any false information is supplied toward securing the permit/any unauthorized changes are made to the site/any unauthorized changes are made in the installation of the system. Improvement Permit with plat valid without expiration. Improvement Permit with site plan valid for sixty months. Authorization to Construct is valid for a period equal to that of Improvement Permit – not to exceed sixty months.

Signed: Richard A Wood date 4-21-98

Improvement Permit by: STEVE HEDRICK date 4-21-98

Authorization to Construct by: STEVE HEDRICK date 4-21-98

Installed by: ROWAN S.T. CO.

Operation Permit by: D. C. Moore date 7-30-98

Existing System Inspection by: date

HEALTH DEPT COPY WHITE INSPECTION COPY (FINAL) GREEN OWNER COPY (FINAL) YELLOW INSPECTION COPY (INITIAL) PINK OWNER COPY (INITIAL) GOLD