IREDELL COUNTY HEALTH DEPARTMENT

STATESVILLE 704-878-5305 MOORESVILLE 704-664-5281

IMPROVEMENT PERMIT / AUTHORIZATION TO CONSTRUCT / OPERATION PERMIT / EXISTING SYSTEM INSPECTION

PERMIT# 84093 PIN# 4772672705

OWNER OR CONTRACTOR Heritage Building Co. PHONE: Business 528-6644 Home DATE OCT 13 99

ADDRESS 120 Hickory Point DR STATESVille NC

LOCATION 5 0W Mt Rd (L) Rumple Hill DA on Right

SUBDIVISION Coppard Springs BLOCK / SECTION LOT 1110 LOT AREA .62Ac SITE CLASS. PS DESIGN FLOW 360 L.T.A.R. .3

Septic Tank: 1000 Gallons: STB 1012 Date 11 14 99

Pump Tank: Gallons: PT Date

Pump Make: Model Serial No.

Nitrification Field: No Fields 1 Square Feet 1200 Linear Feet 400

No Lines 4 Trench Width 36" Max Trench Bottom Depth 36"

☒ New System ☐ Repair System Type: I ☒ II III IV V VI

System Description: Conv GRAVITY

Repair System Description: SAME

Maintenance Agreement Required: ☐ Yes ☒ No

Gravel Depth 12"

☒ House/Mod. Home ☐ Mobile Home ☐ Business ☐ Other

No. Bedrooms 3 No. Bathrooms 2 No. Employees

☐ Slab ☒ Crawl Space ☐ Basement w/plumbing ☐ Basement wo/plumbing


Water Supply: ☒ Individual ☐ Public ☐ Community Well

Comments/Conditions: 4 Drop Boxes


Locate well 100 ft from Septic System or Max Feasible distance, 50 ft min.

Comments/Conditions

INITIAL SITE SKETCH

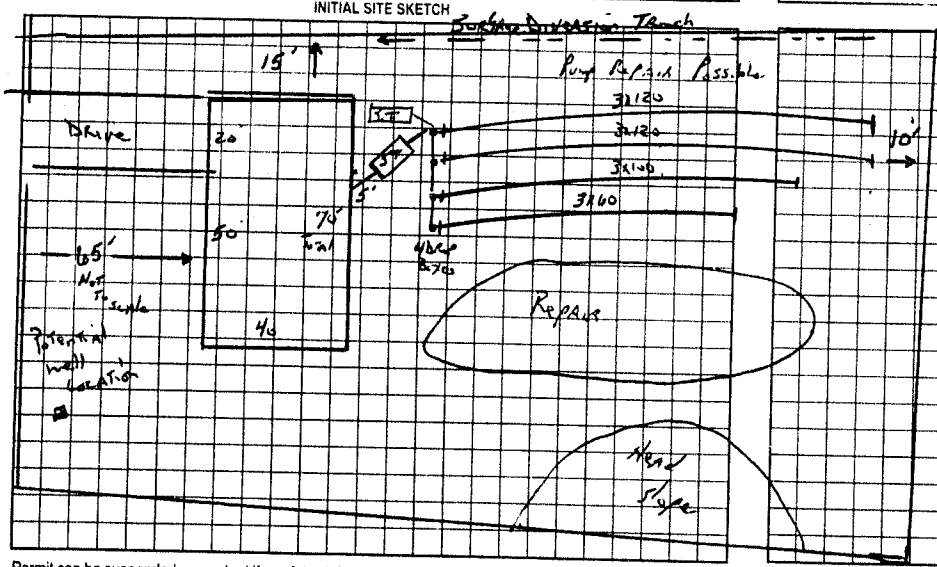

AS BUILT SKETCH

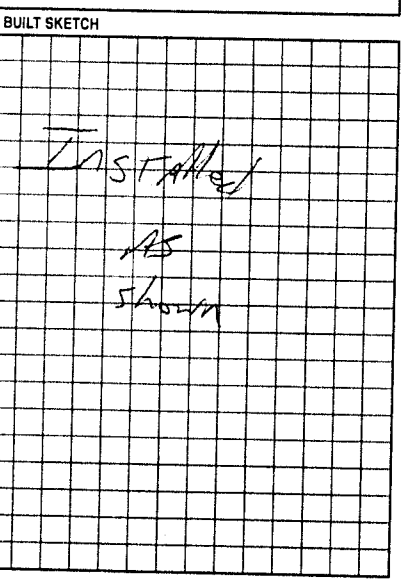

Permit can be suspended or revoked if any false information is supplied toward securing the permit/any unauthorized changes are made to the site/any unauthorized changes are made in the installation of the system. Improvement Permit with plat valid without expiration. Improvement Permit with site plan valid for sixty months. Authorization to Construct is valid for a period equal to that of Improvement Permit – not to exceed sixty months.

Signed: date

Improvement Permit by: Jc Potter date OCT 13 99

Authorization to Construct by: Jc Potter date OCT 13 99

Installed by: Tommy Frye

Operation Permit by: Jc Potter date Feb 23 2000

Existing System Inspection by: date

HEALTH DEPT COPY WHITE OWNER COPY (FINAL) YELLOW OWNER COPY (INITIAL) PINK