IREDELL COUNTY HEALTH DEPARTMENT

STATESVILLE 704-878-5305 MOORESVILLE 704-664-5281

IMPROVEMENT PERMIT / AUTHORIZATION TO CONSTRUCT / OPERATION PERMIT / EXISTING SYSTEM INSPECTION

PERMIT# 107906 PIN# 4722 57 8525 DATE 3/3/05

OWNER OR CONTRACTOR RW ROBIE / ANDRE POUARD PHONE: Business 664-4445 Home

ADDRESS 187 DRUM ST LEXINGTON NC 27292

LOCATION OLD MOUNTAIN RD - TL RUMPLE HILL DR. - TR LEPPARD SPRINGS - 2nd ON LT - CORNER LOT

SUBDIVISION LEPPARD SPRINGS BLOCK / SECTION VII LOT 139 LOT AREA .61AC SITE CLASS. PS DESIGN FLOW 360GPD L.T.A.R. .360GPD

Septic Tank: 1000 Gallons: STB 1012 Date 2-4-05
Pump Tank: Gallons: PT Date
Pump Make: Model Serial No.
Nitrification Field: No Fields 1 Square Feet 900 Linear Feet 300
No Lines 3 @ 4 Trench Width 36" Max Trench Bottom Depth 36" Gravel Depth N/A

☑ New System ☐ Repair System Type: I, II, III, IV, V, VI
System Description: GRAVITY 2-5% REDUCTION
Repair System Description: CONVENTIONAL
Maintenance Agreement Required: ☐ Yes ☑ No


☑ House/Mod. Home No. Bedrooms 3
☐ Mobile Home No. Bathrooms 3
☐ Business No. Employees
☐ Other

☐ Slab ☑ Crawl Space ☐ Basement w/plumbing ☐ Basement wo/plumbing

Water Supply: ☑ Individual ☐ Public ☐ Community


Comments:/Conditions: Mountain 100' away from well 1"=40'

INITIAL SITE SKETCH

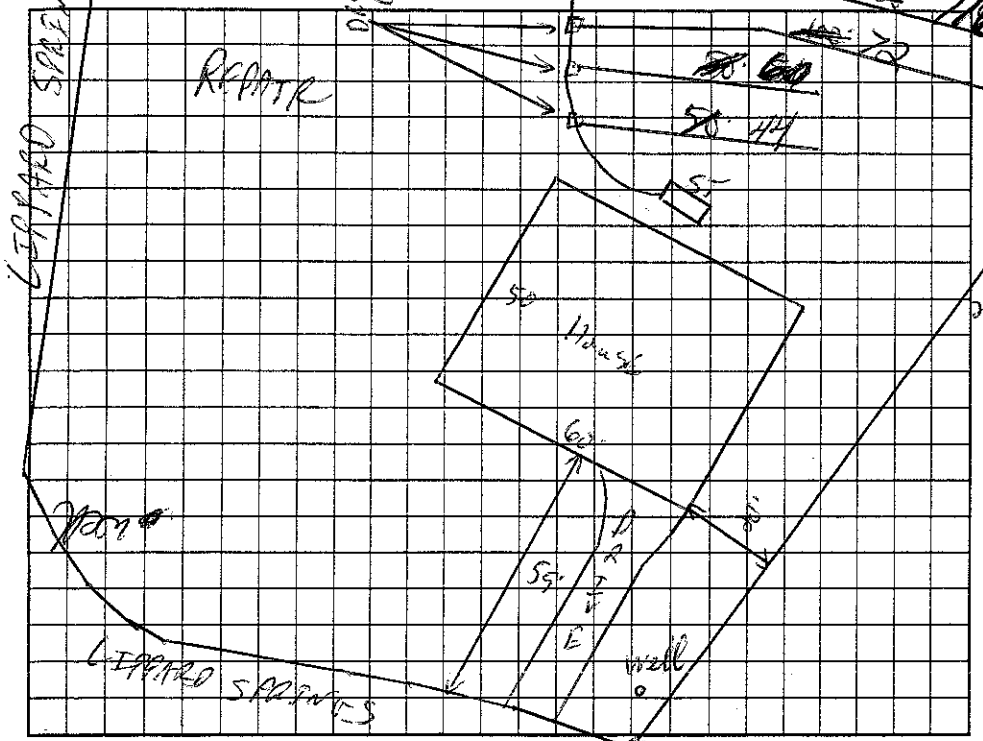

Comments:/Conditions: Septic tank marker installed Yellow trafficlite filter installed Not put in as initial Because of Backfill - Ditch

AS BUILT SKETCH

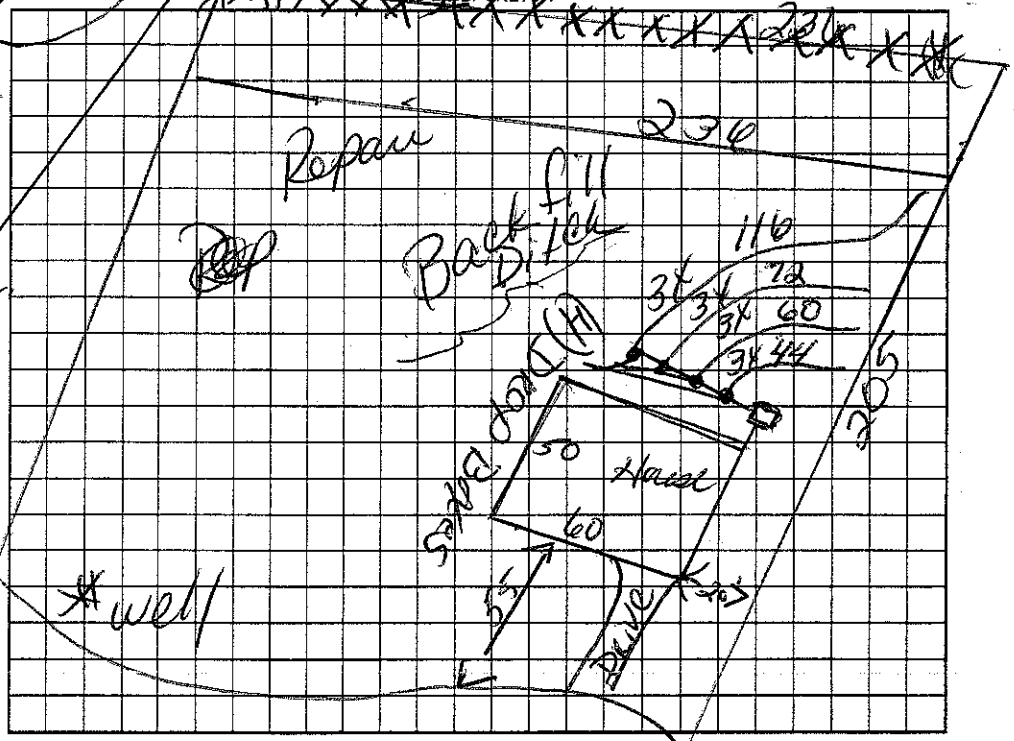

Permit can be suspended or revoked if any false information is supplied toward securing the permit/any unauthorized changes are made to the site/any unauthorized changes are made in the installation of the system. Improvement Permit with plat valid without expiration. Improvement Permit with site plan valid for sixty months. Authorization to Construct is valid for a period equal to that of Improvement Permit – not to exceed sixty months.

Signed: Russell Rowe date

Improvement Permit by: C. Sox RS date 3/3/05

Authorization to Construct by: C. Sox RS date 3/15/05

Installed by: A1 - Backhoe

Operation Permit by: Lee Cook date 8-11-05

Existing System Inspection by: date

HEALTH DEPT. COPY: WHITE OWNER COPY (FINAL): YELLOW OWNER COPY (INITIAL): PINK