IREDELL COUNTY HEALTH DEPARTMENT

STATESVILLE 704-878-5305 MOORESVILLE 704-664-5281

IMPROVEMENT PERMIT / CERTIFICATE OF COMPLETION / OPERATION PERMIT / EXISTING SYSTEM INSPECTION

PROPERTY DESCRIPTION NO. 6849N DATE 8-19-97 TAX MAP NO. 4722 57 8914 Watershed: ☐ Yes ☐ No

OWNER OR CONTRACTOR David L Sharp PHONE: Business Home 538 3567

ADDRESS 168 Buckcreek LN

LOCATION Old mtn Rd Turn Rumple Hill TR Stonefield 3rd lot rt

SUBDIVISION Lippard Sp BLOCK / SECTION LOT 66 LOT AREA 1.5 acre SITE CLASS. PS DESIGN FLOW 360 L.T.A.R. .3

Septic Tank: 1000 Gallons; STB 1007 Date 12-1-97

Pump Tank: Gallons; PT Date

Pump Make: Model Serial No.

Nitrification Field: No Fields 1 Square Feet 1200 Linear Feet 400

No Lines 4 Trench Width 36" Max Trench Bottom Depth 36" Gravel Depth 12"

☑ New System ☐ Repair System Type: I, ☑ II, III, IV, V, VI

System Description: Conv. Gravity

Repair System Description: Gravity/Chambers

Maintenance Agreement Required: ☐ Yes ☑ No

☑ House/Mod. Home No. Bedrooms 3

☐ Mobile Home No. Bathrooms 2

☐ Business No. Employees

☐ Other


☐ Slab ☐ Crawl Space ☐ Basement w/plumbing ☐ Basement wo/plumbing

Water Supply: ☑ Individual ☐ Community ☐ Public


Comments:

Comments:

INITIAL SITE SKETCH 225'

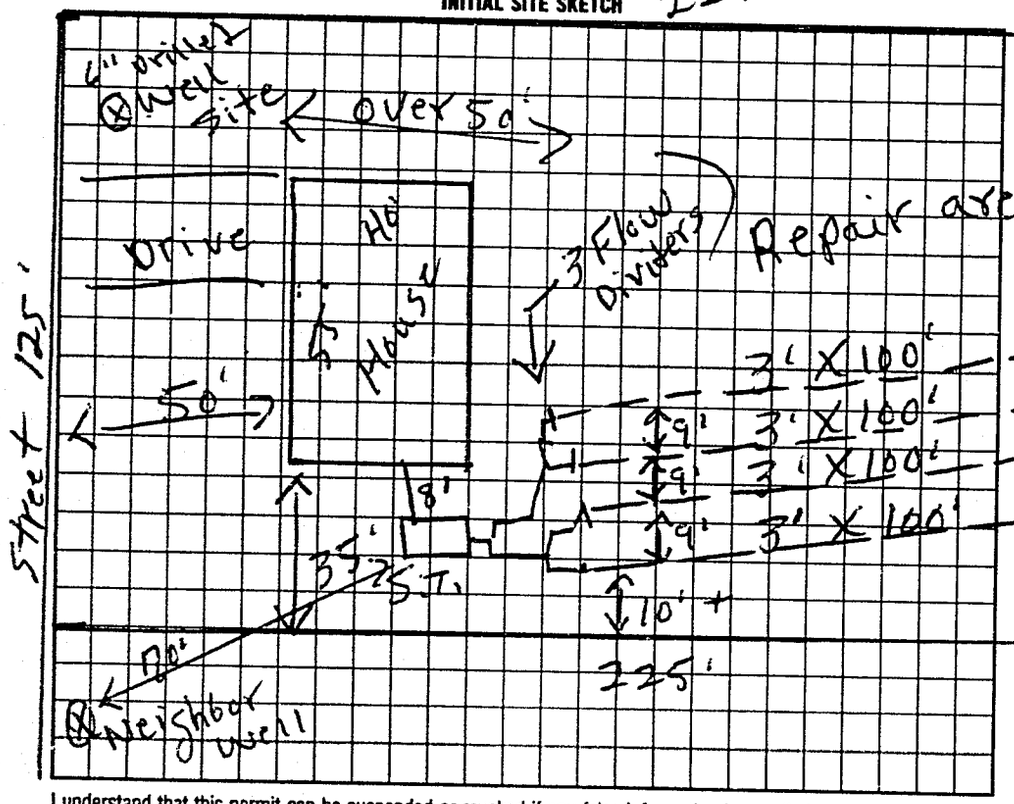

AS BUILT SKETCH

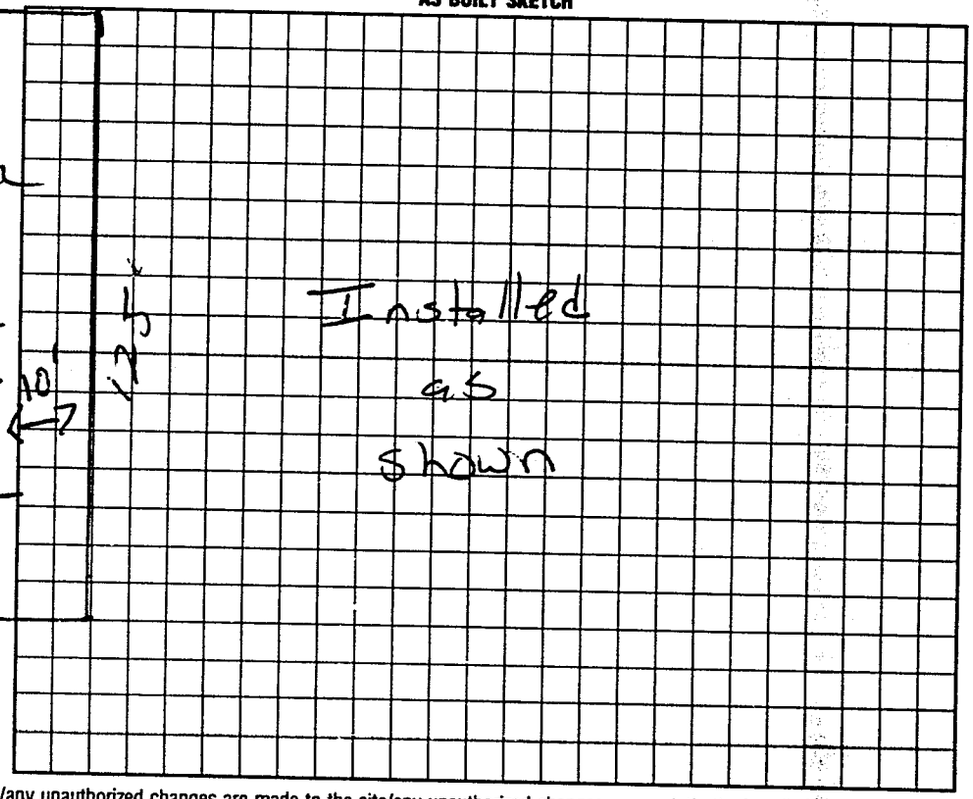

I understand that this permit can be suspended or revoked if any false information is supplied toward securing the permit/any unauthorized changes are made to the site/any unauthorized changes are made in the installation of the system. Improvement Permit is valid for 60 months from date of issuance.

Signed: Judith Sharp

Improvement Permit by: P.C. Moore date 8-19-97

~~Existing System Inspection by:~~ P.C. Moore date 8-19-97

Installed by: Wayne Clontz

Certificate of Completion by: date

Operation Permit by: date 2-13-98

HEALTH DEPT. COPY: WHITE INSPECTION COPY (FINAL): GREEN OWNER COPY (FINAL): YELLOW INSPECTION COPY (INITIAL): PINK OWNER COPY (INITIAL): GOLD

Authorization to const. EXPIRES 60 MOS FROM ISSUE