IREDELL COUNTY HEALTH DEPARTMENT

STATESVILLE 704-878-5305 MOORESVILLE 704-664-5281

IMPROVEMENT PERMIT / AUTHORIZATION TO CONSTRUCT / OPERATION PERMIT / EXISTING SYSTEM INSPECTION

PERMIT# 107905 PIN# 4722-57-9473 DATE 09/04/02

OWNER OR CONTRACTOR R.W. RORIE CONSTRUCTION CO PHONE: Business 704-664-4445 Home

ADDRESS 187 DRUM ST. LINCOLNTON, NC 28092

LOCATION OLD MOUNTAIN RD (L) RUMPLE HILL DR, (R) LIPPARD SPRINGS CR, LOT ON LEFT WHERE LIPPARD SPRINGS CR COMES BACK OUT ON (R) SIDE.

SUBDIVISION LIPPARD SPRINGS BLOCK / SECTION 7 LOT 140 LOT AREA 0.60 ACRES SITE CLASS. PS DESIGN FLOW 360 GPD L.T.A.R. 0.30

Septic Tank: 1,000 Gallons; STB 1012 Date 05/05/02
Pump Tank: ____ Gallons; PT ____ Date ____
Pump Make: ____ Model ____ Serial No. ____
Nitrification Field: No. Fields 1 Square Feet EQ to 1,200 Linear Feet 210
No. Lines 6 x 35' Trench Width 24" Max Trench Bottom Depth 36"


[X] New System [ ] Repair System Type: I, II, (III), IV, V, VI
System Description: 50% REDUCTION
Repair System Description: 50% REDUCTION, LOW PRESSURE
Maintenance Agreement Required: [ ] Yes [X] No
Gravel Depth N/A

[X] House/Mod. Home No. Bedrooms 3
[ ] Mobile Home No. Bathrooms 2
[ ] Business No. Employees ____
[ ] Other ____
[ ] Slab [X] Crawl Space [ ] Basement w/plumbing [ ] Basement wo/plumbing


Water Supply: [X] Individual [ ] Public [ ] Community
WELL

Comments/Conditions: (1) EXISTING WELL MUST BE PROPERLY ABANDONED (2) NEW WELL MUST BE 100 FEET PLUS FROM SYSTEM, ALSO SYSTEM MUST BE 100 FEET PLUS FROM ANY NEIGHBORING WELLS (3) INSTALL SYSTEM USING 48 PANELS (8 PER LINE) TO EQUAL 216 FEET TOTAL LENGTH - SEPTIC TANK INSTALLED USING TUFF-TIGHT FILTER & TANK MARKER * SYSTEM INSTALLED DURING PERIOD OF WET SOIL CONDITIONS,

INITIAL SITE SKETCH

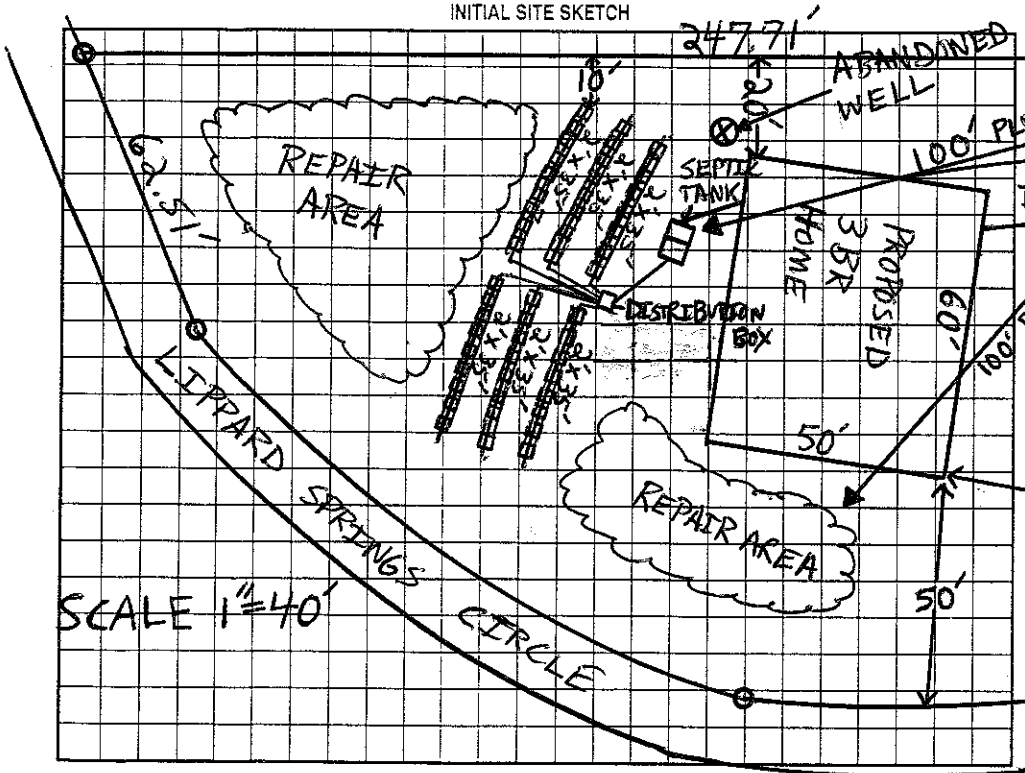

AS BUILT SKETCH

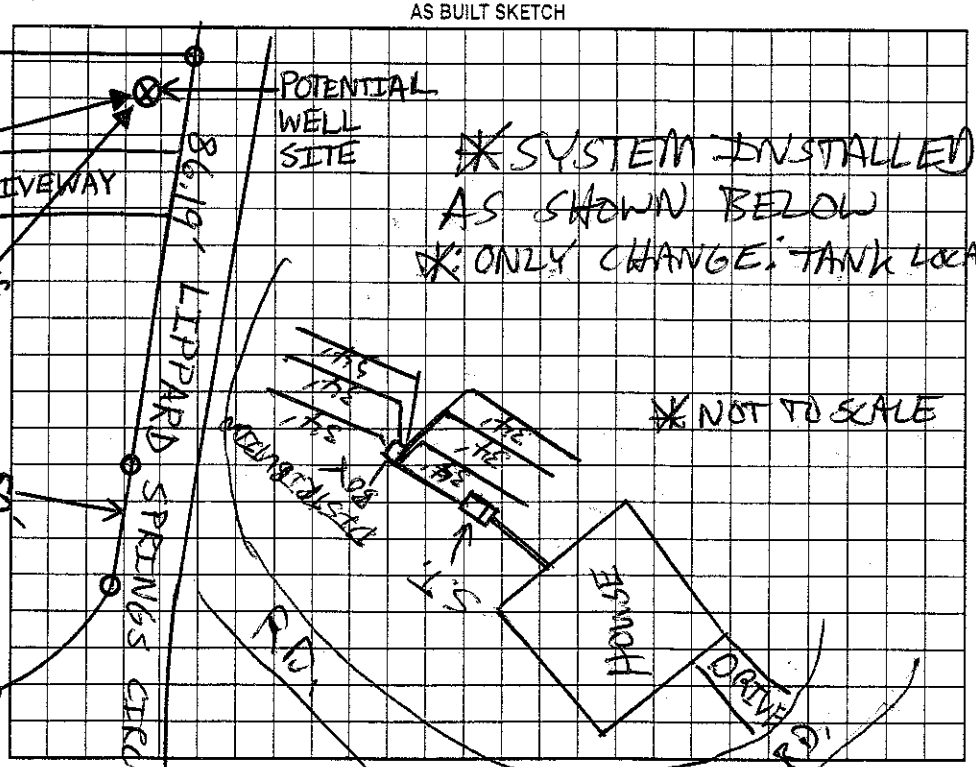

Permit can be suspended or revoked if any false information is supplied toward securing the permit/any unauthorized changes are made to the site/any unauthorized changes are made in the installation of the system. Improvement Permit with plat valid without expiration, Improvement Permit with site plan valid for sixty months. Authorization to Construct is valid for a period equal to that of Improvement Permit – not to exceed sixty months.

Signed: [signature] date 10/2/02 Installed by: TOMMY FRYE 03/04/03

Improvement Permit by: Patrick Mitchell date 10/02/02 Operation Permit by: Patrick Mitchell date 03/04/03

Authorization to Construct by: Patrick Mitchell date 10/11/02 Existing System Inspection by: ____ date ____

HEALTH DEPT. COPY: WHITE OWNER COPY (FINAL): YELLOW OWNER COPY (INITIAL): PINK