IREDELL COUNTY HEALTH DEPARTMENT

STATESVILLE 704-878-5305 MOORESVILLE 704-664-5281

IMPROVEMENT PERMIT / AUTHORIZATION TO CONSTRUCT / OPERATION PERMIT / EXISTING SYSTEM INSPECTION

PERMIT# 076829 PIN# 4722 58 0448 DATE 10-19-98

OWNER OR CONTRACTOR BILLY LITTLE PHONE: Business 871-2015 Home 872-2741

ADDRESS 316 GASTON COURT STATESVILLE NC 28677

LOCATION I-40 WEST, TL OLD MTN ROAD, TL RUMPLE HILL DRIVE, TL ST. JOSEPH CT, 1ST ON LEFT

SUBDIVISION LIPPARD SPRINGS BLOCK / SECTION IV LOT 72 LOT AREA 0.71 ACRES SITE CLASS. PSI DESIGN FLOW 360 L.T.A.R. 0.30 GPD/FT

Septic Tank: 1000 Gallons; STB 794 Date 10-7-98
Pump Tank: ____ Gallons; PT ____ Date ____
Pump Make: ____ Model ____ Serial No. ____
Nitrification Field: No Fields 1 Square Feet 69.75 to 1299 linear Feet 300+
No Lines THREE Trench Width 36" Max Trench Bottom Depth 36"

[X] New System [ ] Repair System Type: I, II, III, IV, V, VI
System Description: 25% REDUCTION GRAVITY
Repair System Description: 25% REDUCTION PUMP
Maintenance Agreement Required: [ ] Yes [X] No
Depth: SAND [ ] Slab [X] Crawl Space [ ] Basement w/plumbing [ ] Basement wo/plumbing


[X] House/Mod. Home No. Bedrooms 3
[ ] Mobile Home No. Bathrooms 2½
[ ] Business No. Employees ____
[ ] Other ____

Water Supply: [X] Individual [X] Public [ ] Community WELL


Comments:/Conditions: ① INSTALL 25% REDUCTION SYSTEM USING FIFTY CHAMBERS OR THIRTY H.D.S. SECTIONS ② STUB-OUT PLUMBING ABOVE FOOTING AS HIGH AS POSSIBLE TO KEEP SYSTEM SHALLOW

Comments:/Conditions:

INITIAL SITE SKETCH SCALE: 1" = 50'

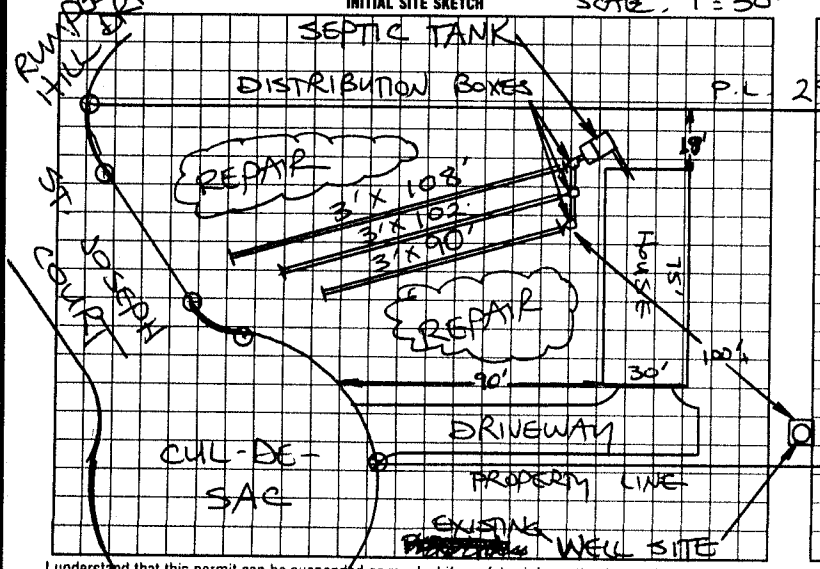

AS BUILT SKETCH

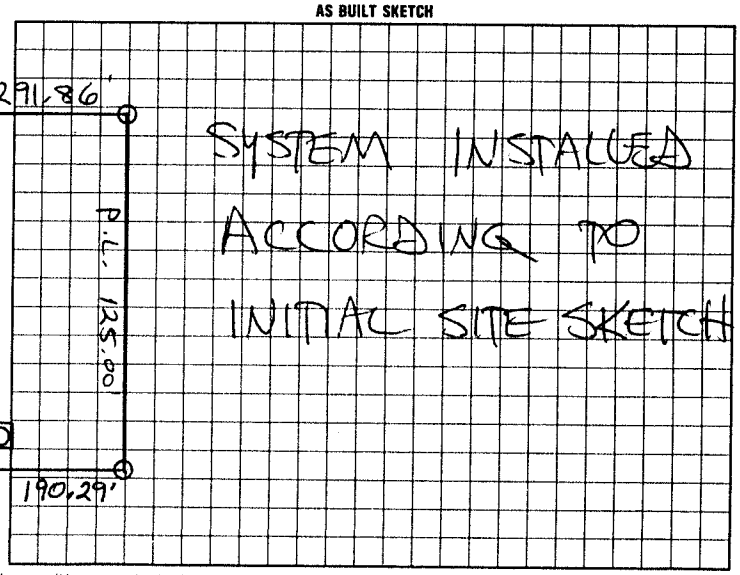

I understand that this permit can be suspended or revoked if any false information is supplied toward securing the permit/any unauthorized changes are made to the site/any unauthorized changes are made in the installation of the system. Improvement Permit with plat valid without expiration. Improvement Permit with site plan valid for sixty months. Authorization to Construct is valid for a period equal to that of Improvement Permit – not to exceed sixty months.

Signed: Billy Little date 10.27.98

Improvement Permit by: STEVE HEDRICK date 10-19-98

Authorization to Construct by: STEVE HEDRICK date 10-19-98

Installed by: C. WAYNE ORBISON & SONS INC

Operation Permit by: STEVE HEDRICK date 1-29-99

Existing System Inspection by: ____ date ____

HEALTH DEPT. COPY: WHITE INSPECTION COPY (FINAL): GREEN OWNER COPY (FINAL) YELLOW INSPECTION COPY (INITIAL): PINK OWNER COPY (INITIAL): GOLD