IREDELL COUNTY HEALTH DEPARTMENT

THIS PERMIT REPLACES EXPIRED PERMIT # 070078

STATESVILLE 704-878-5305 (C) MOORESVILLE 704-664-5281

IMPROVEMENT PERMIT / AUTHORIZATION TO CONSTRUCT / OPERATION PERMIT / EXISTING SYSTEM INSPECTION

PERMIT# 122806 PIN# 4722-58-1215 DATE 8-4-04

OWNER OR CONTRACTOR PAUL BARRY PHONE: Business 704-400-3646 Home

ADDRESS 370 WATER STREET, MOORESVILLE NC 28115

LOCATION OLD MOUNTAIN ROAD TO RUMPLE HILL DRIVE, 2ND LOT ON LEFT BEFORE ST. JOSEPH COURT

SUBDIVISION LIPPARD SPRINGS BLOCK / SECTION IV LOT 70 LOT AREA 0.67 ACRE SITE CLASS. PS DESIGN FLOW 360 L.T.A.R. 0.30 GPD/FT²

Septic Tank: 1000 Gallons; STB 10/2 Date 6-19-04

Pump Tank: Gallons; PT Date

Pump Make: Model Serial No.

Nitrification Field: No Fields 1 Square Feet 1200 Linear Feet 400

No Lines FOUR Trench Width 36" Max Trench Bottom Depth 36" Gravel Depth 12"

☑ New System ☐ Repair System Type: I, (II), III, IV, V, VI

System Description: CONVENTIONAL GRAVITY

Repair System Description: 25% REDUCTION, GRAVITY

Maintenance Agreement Required: ☐ Yes ☑ No

☐ House/Mod. Home No. Bedrooms 3

☐ Mobile Home No. Bathrooms

☐ Business No. Employees

☐ Other

☐ Slab ☑ Crawl Space ☐ Basement w/plumbing ☐ Basement wo/plumbing

Water Supply: ☑ Individual ☐ Public ☐ Community

WELL


Comments/Conditions: ① INSTALL DRAINLINES ON CONTOUR AS SHOWN

② KEEP SYSTEM MINIMUM 100 FEET FROM WELL

Comments/Conditions: ① SEPTIC TANK WITH MARKER INSTALLED USING "TUFTITE" FILTER

② SYSTEM INSTALLED DURING PERIOD OF WET SOIL CONDITIONS

INITIAL SITE SKETCH

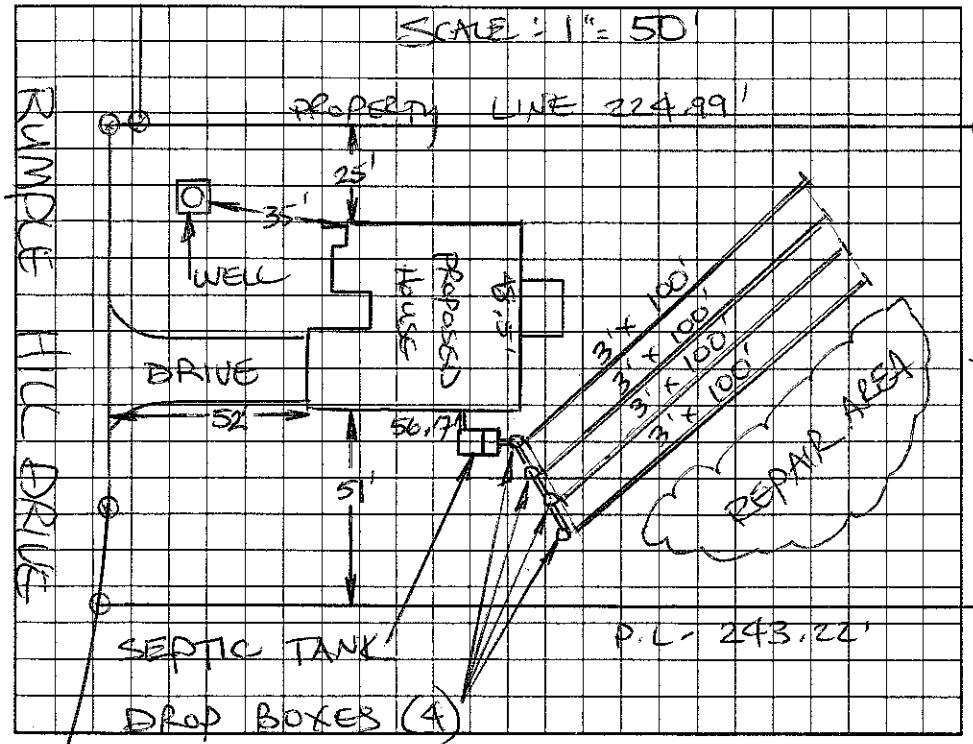

AS BUILT SKETCH

SYSTEM INSTALLED ACCORDING TO INITAL SITE SKETCH

Permit can be suspended or revoked if any false information is supplied toward securing the permit/any unauthorized changes are made to the site/any unauthorized changes are made in the installation of the system. Improvement Permit with plat valid without expiration. Improvement Permit with site plan valid for sixty months. Authorization to Construct is valid for a period equal to that of Improvement Permit – not to exceed sixty months.

Signed: date 8-4-04

Improvement Permit by: STEVE HEDRICK date 8-4-04

Authorization to Construct by: STEVE HEDRICK date 8-4-04

Installed by: FOREST STYFORD

Operation Permit by: STEVE HEDRICK date 12-2-04

Existing System Inspection by: date

HEALTH DEPT. COPY: WHITE OWNER COPY (FINAL): YELLOW OWNER COPY (INITIAL): PINK