IREDELL COUNTY HEALTH DEPARTMENT

STATESVILLE 704-878-5305 MOORESVILLE 704-664-5281

IMPROVEMENT PERMIT / AUTHORIZATION TO CONSTRUCT / OPERATION PERMIT / EXISTING SYSTEM INSPECTION

PERMIT# 078279 PIN# 4722 58 2678 DATE 1-8-99

OWNER OR CONTRACTOR HERITAGE BUILDING COMPANY PHONE: Business _____ Home 528-6644

ADDRESS 120 HICKORY POINT ST. STATESVILLE, NC 28677

LOCATION I-40 W TL OLD MTN RD, TL RUMPLE HILL DR, 1ST LOT ON LEFT PAST ST. JOSEPH COURT

SUBDIVISION LIPPARD SPRINGS BLOCK / SECTION _____ LOT 76 LOT AREA 0.76 ACRE SITE CLASS. RS DESIGN FLOW 360 L.T.A.R. 0.25 GPD/FT²

Septic Tank: 1000 Gallons; STB 1012 Date 4-23-99
Pump Tank: _____ Gallons; PT _____ Date _____
Pump Make: _____ Model _____ Serial No. _____
Nitrification Field: No Fields I Square Feet 1440 Linear Feet 480
No Lines SIX Trench Width 36" Max Trench Bottom Depth 28" Gravel Depth 12"

☒ New System ☐ Repair System Type: I (II) III, IV, V, VI
System Description: CONVENTIONAL SYSTEM
Repair System Description: 25% REDUCTION GRAY
Maintenance Agreement Required: ☐ Yes ☒ No
☐ Slab ☒ Crawl Space ☐ Basement w/plumbing ☐ Basement wo/plumbing

☒ House/Mod. Home No. Bedrooms 3
☐ Mobile Home No. Bathrooms 2
☐ Business No. Employees _____
☐ Other _____


Water Supply: ☒ Individual ☐ Public ☐ Community
WELL

Comments:/Conditions: INSTALL SUBSURFACE INTERCEPT DRAINAGE DITCH AT LOCATION SHOWN BEGINNING 40 INCHES DEEP OUT TO DAYLIGHT

SCALE: 1"=50'

Comments:/Conditions:
6-4 Checked system by Max
6-7 Subsurface drain checked o/s Jef

INITIAL SITE SKETCH

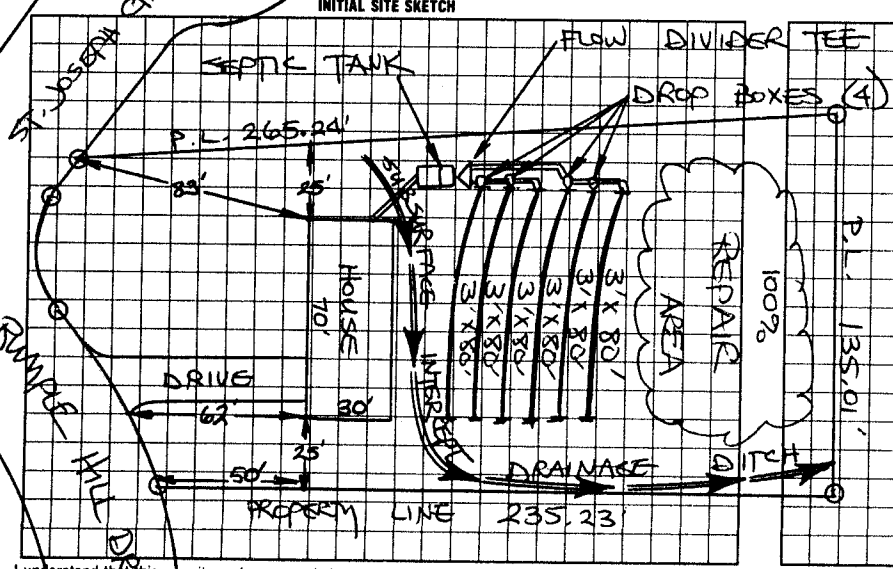

AS BUILT SKETCH

I understand that this permit can be suspended or revoked if any false information is supplied toward securing the permit/any unauthorized changes are made to the site/any unauthorized changes are made in the installation of the system. Improvement Permit with plat valid without expiration. Improvement Permit with site plan valid for sixty months. Authorization to Construct is valid for a period equal to that of Improvement Permit – not to exceed sixty months.

Signed: _____ date 1-25-99 Installed by: Tommy Frye

Improvement Permit by: STEVE HEDRICK date 1-8-99 Operation Permit by: _____ date 6-7-99

Authorization to Construct by: STEVE HEDRICK date 1-8-99 Existing System Inspection by: _____ date _____

HEALTH DEPT. COPY: WHITE INSPECTION COPY (FINAL): GREEN OWNER COPY (FINAL): YELLOW INSPECTION COPY (INITIAL): PINK OWNER COPY (INITIAL): GOLD