IREDELL COUNTY HEALTH DEPARTMENT

STATESVILLE 704-878-5305 MOORESVILLE 704-664-5281

IMPROVEMENT PERMIT / AUTHORIZATION TO CONSTRUCT / OPERATION PERMIT / EXISTING SYSTEM INSPECTION

PERMIT# 078218 PIN# 4722 58 4462 DATE 1-4-99

OWNER OR CONTRACTOR HERITAGE BUILDING CO. PHONE: Business 528-6644 Home

ADDRESS 120 HICKORY PLACE COURT, STATESVILLE, NC 28677

LOCATION I-40 W, TL OLD MTN. RD, TL RUMPLE HILL DRIVE, LOT ON RIGHT [redacted] ST. JOSEPH'S COURT

SUBDIVISION LIPPARD SPRINGS BLOCK / SECTION LOT 103 LOT AREA 0.79 ACRE SITE CLASS. PS DESIGN FLOW 360 L.T.A.R. 0.33 SPD/FT²

Septic Tank: 1000 Gallons; STB 1012 Date 4-2399

Pump Tank: Gallons; PT Date

Pump Make: Model Serial No.

Nitrification Field: No Fields 1 Square Feet 1080 Linear Feet 360

No Lines THREE Trench Width 36" Max Trench Bottom Depth 36"

☑ New System ☐ Repair System Type: I II III IV V VI

System Description: CONVENTIONAL GRAVITY

Repair System Description: CONV. GRAVITY

Maintenance Agreement Required: ☐ Yes ☑ No pump

Gravel Depth 12"

☑ House/Mod. Home No. Bedrooms 3

☐ Mobile Home No. Bathrooms 2

☐ Business No. Employees

☐ Other


☐ Slab ☑ Crawl Space ☐ Basement w/plumbing ☐ Basement wo/plumbing

Water Supply: ☑ Individual ☐ Public ☐ Community WELL


Comments:/Conditions: KEEP SYSTEM MINIMUM 100 FEET FROM WELL

Comments:/Conditions:

INITIAL SITE SKETCH

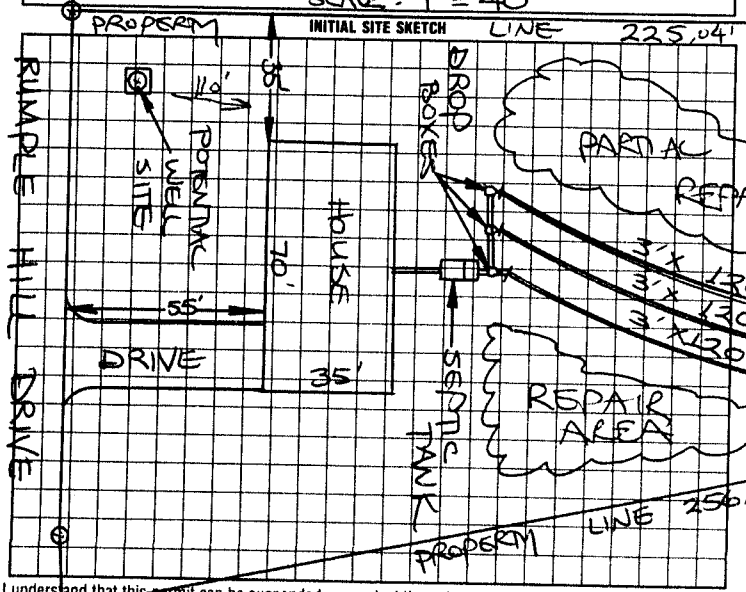

AS BUILT SKETCH

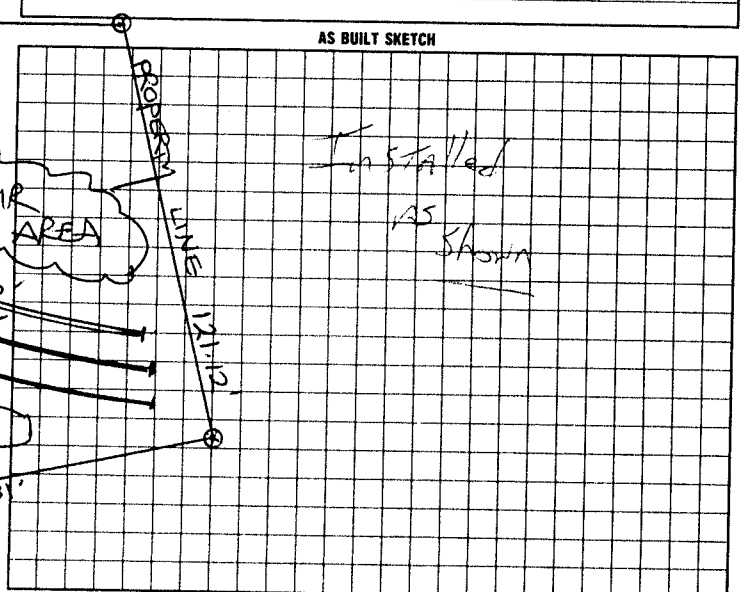

I understand that this permit can be suspended or revoked if any false information is supplied toward securing the permit/any unauthorized changes are made to the site/any unauthorized changes are made in the installation of the system. Improvement Permit with plat valid without expiration. Improvement Permit with site plan valid for sixty months. Authorization to Construct is valid for a period equal to that of Improvement Permit – not to exceed sixty months.

Signed: date 1-5-99

Improvement Permit by: STEVE HEDRICK date 1-4-99

Authorization to Construct by: STEVE HEDRICK date 1-4-99

Installed by: Tommy Frye

Operation Permit by: date 6-7-99

Existing System Inspection by: date

HEALTH DEPT. COPY: WHITE INSPECTION COPY (FINAL): GREEN OWNER COPY (FINAL): YELLOW INSPECTION COPY (INITIAL): PINK OWNER COPY (INITIAL): GOLD