IREDELL COUNTY HEALTH DEPARTMENT

STATESVILLE 704-878-5305 MOORESVILLE 704-664-5281

IMPROVEMENT PERMIT / CERTIFICATE OF COMPLETION / OPERATION PERMIT / EXISTING SYSTEM INSPECTION

PROPERTY DESCRIPTION NO. 25153 06725 DATE 10-15-96 TAX MAP NO. 6C-6-A-48 Watershed: ☐ Yes ☐ No

OWNER OR CONTRACTOR Heritage Building Co. PHONE: Business 528-6644 Home

ADDRESS 120 Hickory Pointe Ct. Statesville NC

LOCATION Old Mtn Rd before Kyles Rd Turn Rumple Dr. Tr Stonefield 3rd lot left

SUBDIVISION Lippard Sp. BLOCK / SECTION LOT 48 LOT AREA 125X225' SITE CLASS PS DESIGN FLOW 360 L.T.A.R. .13

Septic Tank: 1000 Gallons; STB Date

Pump Tank: Gallons; PT Date

Pump Make: Model Serial No.

Nitrification Field: No Fields 1 Square Feet 900 Linear Feet 300

No Lines 3 Trench Width 36" Max Trench Bottom Depth 36" Gravel Depth N/A

☑ New System ☐ Repair System Type: I, II, III, IV, V, VI

System Description: Gravity Chambers

Repair System Description: Pump To Chambers

Maintenance Agreement Required: ☐ Yes ☐ No Pumped

☑ House/Mod. Home ☐ Mobile Home ☐ Business ☐ Other

No. Bedrooms 3 No. Bathrooms 2 No. Employees


☐ Slab ☐ Crawl Space ☐ Basement w/plumbing ☐ Basement wo/plumbing

Water Supply: ☑ Individual ☐ Community ☐ Public


Comments:

Comments: * Note Lines angle back

INITIAL SITE SKETCH

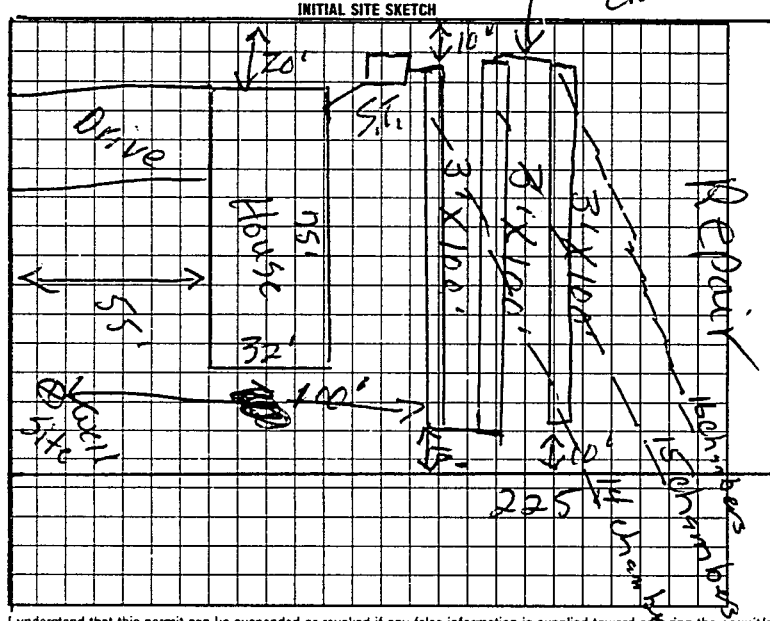

AS BUILT SKETCH

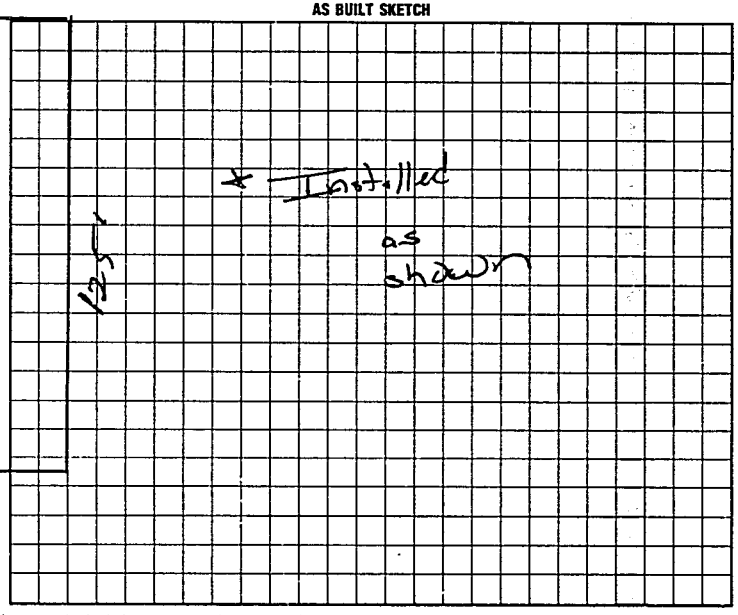

I understand that this permit can be suspended or revoked if any false information is supplied toward securing the permit/any unauthorized changes are made to the site/any unauthorized changes are made in the installation of the system.

Signed:

Improvement Permit by: P.C. moore date 10-15-96

Existing System Inspected by: P.C. moore date 10-15-96

Authorization to Construct

Installed by: Tommy Frye

Certificate of Completion by: date

Operation Permit by Mark C Oji RS date 8-14-97

HEALTH DEPT. COPY (WHITE) INSPECTION COPY (FINAL): GREEN OWNER COPY (FINAL): YELLOW INSPECTION COPY (INITIAL): PINK OWNER COPY (INITIAL): GOLD

Authorization to Const Expires 60 mos from issue

80100