IREDELL COUNTY HEALTH DEPARTMENT

STATESVILLE 704-878-5305 (C1) MOORESVILLE 704-664-5281

IMPROVEMENT PERMIT / AUTHORIZATION TO CONSTRUCT / OPERATION PERMIT / EXISTING SYSTEM INSPECTION

PERMIT# 071347 PIN# 4772672705 (PT) DATE 4-3-98

OWNER OR CONTRACTOR Heritage Building Co/Rick Dyson PHONE: Business 528-6641 Home

ADDRESS 120 Hickory Place Ct. Statesville, NC 28677

LOCATION Old Mountain Rd TR Rumple Hill Dr On right

SUBDIVISION Lippard Spgs BLOCK / SECTION LOT 101 LOT AREA .70 Acres SITE CLASS PS DESIGN FLOW 360 gpd L.T.A.R. .275 - .3

Septic Tank: 1000 Gallons; STB 1012 Date 12-16-01
Pump Tank: 1000 Gallons; PT 17 Date 12-21-01
Pump Make: GOULDS Model WE0511H Serial No D025767S
Nitrification Field: No Fields 4 Square Feet 1660 Linear Feet 415'
No Lines 4 Trench Width 36" Max Trench Bottom Depth 33"

[X] New System [ ] Repair System Type: I, II, (III) IV, V, VI
System Description: Pump (PM) - Conventional
Repair System Description: Same
Maintenance Agreement Required: [ ] Yes [X] No
Gravel Depth 12" [ ] Slab [X] Crawl Space [ ] Basement w/plumbing [ ] Basement wo/plumbing


[X] House/Mod. Home No. Bedrooms 3
[ ] Mobile Home No. Bathrooms 2
[ ] Business No. Employees
[ ] Other

Water Supply: [X] Individual [ ] Public [ ] Community


Comments:/Conditions: Keep System at least 10' from PL, at least 5' from House & 100' from well

Comments:/Conditions: SEPTIC TANK WITH MARKER INSTALLED USING "POLYLOK" FILTER

INITIAL SITE SKETCH Scale 1:50

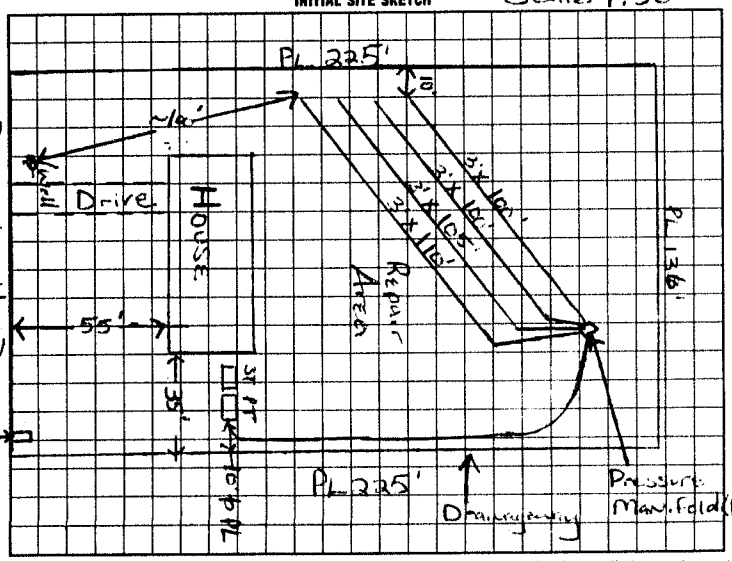

AS BUILT SKETCH

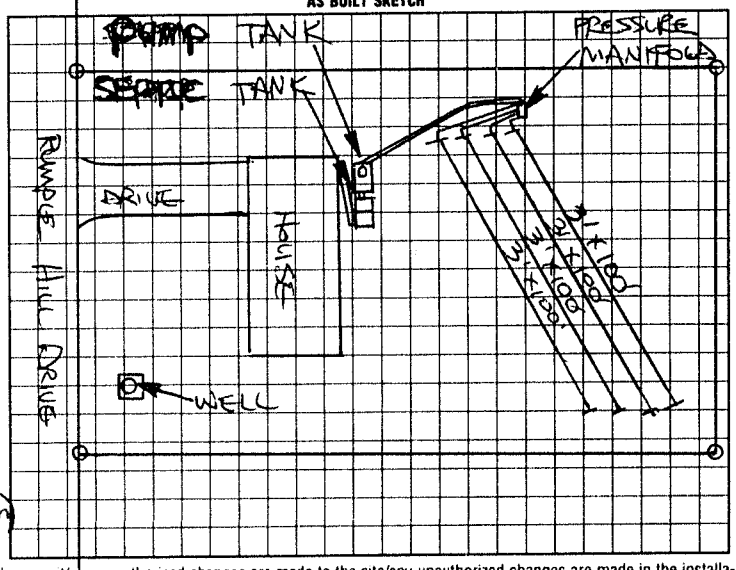

I understand that this permit can be suspended or revoked if any false information is supplied toward securing the permit/any unauthorized changes are made to the site/any unauthorized changes are made in the installation of the system. Improvement Permit with plat valid without expiration. Improvement Permit with site plan valid for sixty months. Authorization to Construct is valid for a period equal to that of Improvement Permit – not to exceed sixty months.

Signed: _____ date 2-25-02 Installed by: TOMMY FRYE

Improvement Permit by: _____ date 4/6/98 Operation Permit by: STEVE HEDRICK date 7-22-02

Authorization to Construct by: STEVE HEDRICK date 2-25-02 Existing System Inspection by: _____ date _____

HEALTH DEPT. COPY: WHITE INSPECTION COPY (FINAL): GREEN OWNER COPY (FINAL): YELLOW INSPECTION COPY (INITIAL): PINK OWNER COPY (INITIAL): GOLD