IREDELL COUNTY HEALTH DEPARTMENT

STATESVILLE 704-878-5305 MOORESVILLE 704-664-5281

IMPROVEMENT PERMIT / CERTIFICATE OF COMPLETION / OPERATION PERMIT / EXISTING SYSTEM INSPECTION

PROPERTY DESCRIPTION NO. ~~2515~~ 7264 DATE 10-15-96 TAX MAP NO. 6C-6-A-49 Watershed: ☐ Yes ☑ No

OWNER OR CONTRACTOR Heritage Bldg Co. PHONE: Business 528-6644 Home

ADDRESS 120 Hickory Parkway Ct. Statesville 28677

LOCATION Buffalo Shoals TL old mtn, TR Rumple TR Stonefield 4th lot Left

SUBDIVISION Lippard Sp. BLOCK / SECTION LOT 49 LOT AREA 125x225 SITE CLASS P3 DESIGN FLOW 360 L.T.A.R. 1.3

Septic Tank: 1000 Gallons; STB 1012 Date 6-8-97
Pump Tank: Gallons; PT Date
Pump Make: Model Serial No.
Nitrification Field: ☐ No Fields ☑ Square Feet 900 Linear Feet 300
No Lines 3 Trench Width 36" Max Trench Bottom Depth 36" Gravel Depth N/A

☑ New System ☐ Repair System Type: I, II, III, IV, V, VI
System Description: Gravity Chambers
Repair System Description: Pump To chambers
Maintenance Agreement Required: ☐ Yes ☐ No

☑ House/Mod. Home No. Bedrooms 3
☐ Mobile Home No. Bathrooms 2
☐ Business No. Employees
☐ Other
☐ Slab ☑ Crawl Space ☐ Basement w/plumbing ☐ Basement wo/plumbing

Water Supply: ☑ Individual ☐ Community ☐ Public


Comments:

3" sch 40 Cross over PIPE


Comments:

* 3rd line deeper than 36in

INITIAL SITE SKETCH

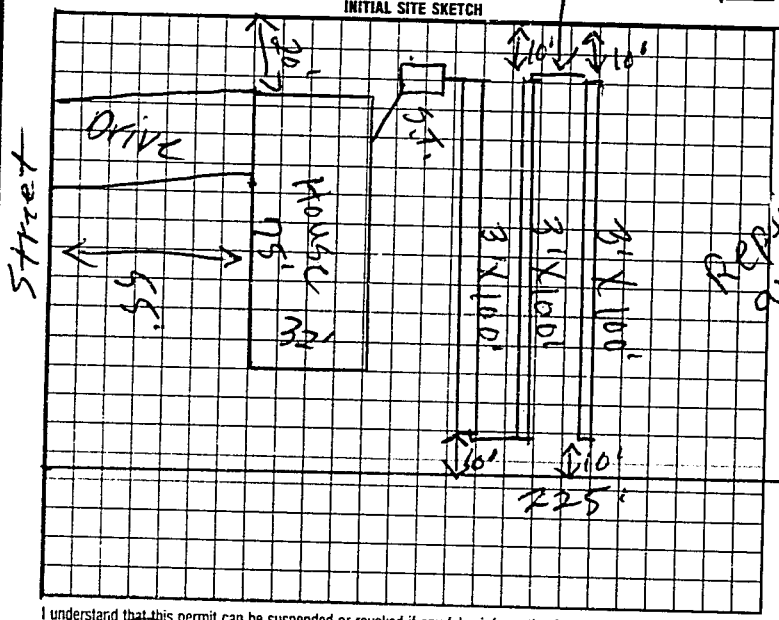

AS BUILT SKETCH

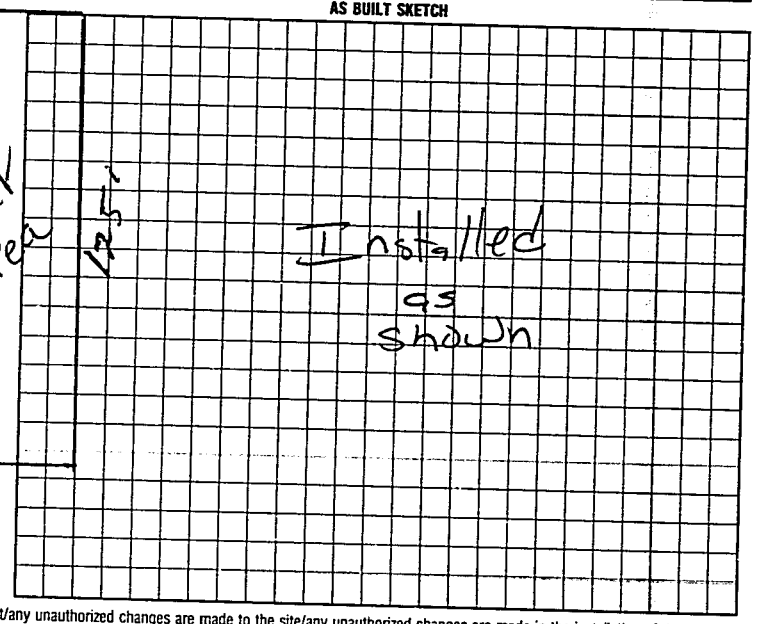

I understand that this permit can be suspended or revoked if any false information is supplied toward securing the permit/any unauthorized changes are made to the site/any unauthorized changes are made in the installation of the system.

Signed:

Improvement Permit by: R. C. Moore date 10-15-96

Existing System Evaluation by: R. C. Moore date 10-15-96

Installed by: Tommy Frye

Certificate of Completion by: date

Operation Permit by Mark C. Ott P3 date 7-14-97

Authorization to Const. Expires 60 mos from issue.

HEALTH DEPT COPY (WHITE) INSPECTION COPY (FINAL) GREEN OWNER COPY (FINAL) YELLOW INSPECTION COPY (INITIAL) PINK OWNER COPY (INITIAL) GOLD