IREDELL COUNTY HEALTH DEPARTMENT

STATESVILLE 704-878-5305 MOORESVILLE 704-664-5281

IMPROVEMENT PERMIT / AUTHORIZATION TO CONSTRUCT / OPERATION PERMIT / EXISTING SYSTEM INSPECTION

PERMIT# 971346 PIN# 4772672705 (PT) DATE 3/20/98

OWNER OR CONTRACTOR Heritage Builders / Rick Dyson PHONE: Business (704) 528-6644 Home

ADDRESS 120 Hickory Place Ct. Statesville, NC 28677

LOCATION Old Mountain Rd TR Rumple Hill Rd 7th lot on right past Stone Field

SUBDIVISION Lippard Spgs BLOCK / SECTION 4 LOT 100 LOT AREA .65 Acre SITE CLASS PS DESIGN FLOW 360 gpd L.T.A.R. .3

Septic Tank: 1000 Gallons; STB 1012 Date 1-9-99
Pump Tank: _____ Gallons; PT _____ Date _____
Pump Make: _____ Model _____ Serial No. _____
Nitrification Field: No Fields 1 Square Feet 1200 Linear Feet 400
No Lines 3 at 133' Trench Width 36" Max Trench Bottom Depth 22"

[X] New System [ ] Repair System Type: [ ] I [ ] II [ ] III [ ] IV [ ] V [ ] VI
System Description: Gravity - Conventional
Repair System Description: Same
Maintenance Agreement Required: [ ] Yes [ ] No
Gravel Depth 12" [ ] Slab [X] Crawl Space [ ] Basement w/plumbing [ ] Basement wo/plumbing


[X] House/Mod. Home No. Bedrooms 3
[ ] Mobile Home No. Bathrooms 2
[ ] Business No. Employees _____
[ ] Other _____

Water Supply: [X] Individual [ ] Public [ ] Community

Comments:/Conditions: Keep Septic System at least 5' from House & 10' from Front PL & 100' from well


Comments:/Conditions: SEPTIC TANK WITH RISERS INSTALLED WITH "POLYLOK" FILTER

INITIAL SITE SKETCH Scale 1:50

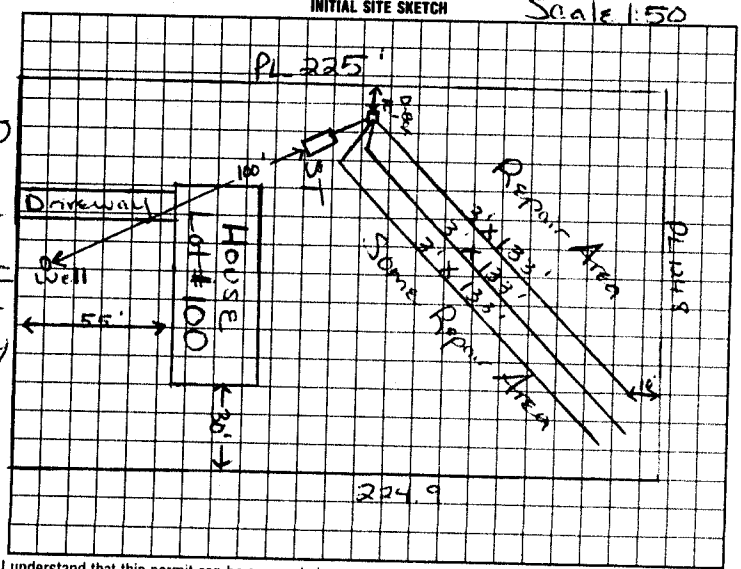

Rumple Hill Dr.

AS BUILT SKETCH

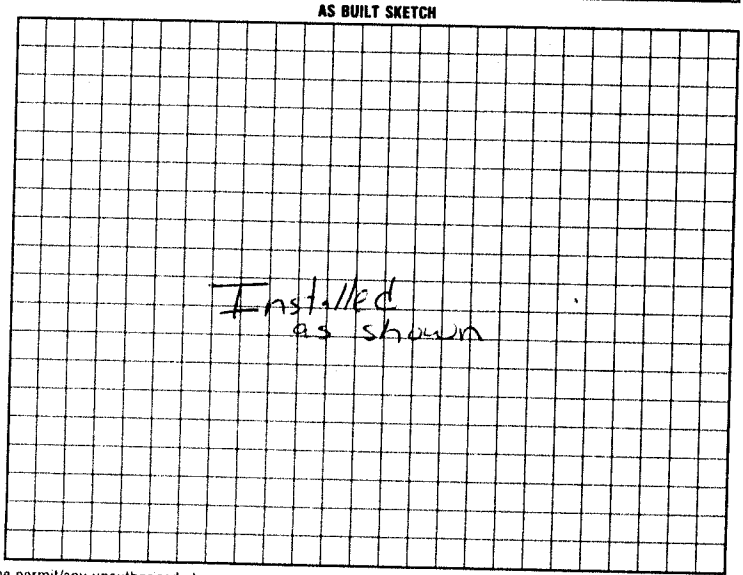

I understand that this permit can be suspended or revoked if any false information is supplied toward securing the permit/any unauthorized changes are made to the site/any unauthorized changes are made in the installation of the system. Improvement Permit with plat valid without expiration. Improvement Permit with site plan valid for sixty months. Authorization to Construct is valid for a period equal to that of Improvement Permit – not to exceed sixty months.

Signed: _____

Improvement Permit by: Marian H. Dotson date 3/26/98

Authorization to Construct by: STEVE HEDRICK date 10/15/98

Installed by: Jimmy Fry

Operation Permit by: [illegible] County date 3-19-99

Existing System Inspection by: _____ date _____

HEALTH DEPT. COPY: WHITE INSPECTION COPY (FINAL): GREEN OWNER COPY (FINAL) YELLOW INSPECTION COPY (INITIAL) PINK OWNER COPY (INITIAL) GOLD