IREDELL COUNTY HEALTH DEPARTMENT

STATESVILLE 704-878-5305 MOORESVILLE 704-664-5281

IMPROVEMENT PERMIT / AUTHORIZATION TO CONSTRUCT / OPERATION PERMIT / EXISTING SYSTEM INSPECTION

PERMIT# 971346 PIN# 4772672705 (PT) DATE 3/20/98

OWNER OR CONTRACTOR Heritage Builders / Rick Dyson PHONE: Business (704) 528-6644 Home

ADDRESS 120 Hickory Place Ct / Statesville NC 28677

LOCATION Old Mountain Rd TR Rumple Hill Dr 7th lot on right past Stone Field

SUBDIVISION Leppard Spgs BLOCK / SECTION 4 LOT 160 LOT AREA .65 Acre SITE CLASS PS DESIGN FLOW 300gpd L.T.A.R. .3

Septic Tank: 1000 Gallons: STB 1012 Date 1-9-99
Pump Tank: ____ Gallons: PT ____ Date ____
Pump Make: ____ Model ____ Serial No. ____
Nitrification Field: No Fields 1 Square Feet 1200 Linear Feet 400
No Lines 2 at 133' Trench Width 36" Max Trench Bottom Depth 22" Gravel Depth 12"

[X] New System [ ] Repair System Type: [ ] I [ ] II [ ] III [ ] IV [ ] V [ ] VI
System Description: Gravity - Conventional
Repair System Description: Same
Maintenance Agreement Required [ ] Yes [ ] No

[X] House/Mod. Home [ ] Mobile Home [ ] Business [ ] Other
No. Bedrooms 3 No. Bathrooms 2 No. Employees ____


[ ] Slab [X] Crawl Space [ ] Basement w/plumbing [ ] Basement wo/plumbing

Water Supply: [X] Individual [ ] Public [ ] Community

Comments/Conditions: Keep Septic System at least 5' from house & 10' from PL & 100' from well

Comments/Conditions: SEPTIC TANK WITH RISERS INSTALLED WITH "Polylok" FILTER

INITIAL SITE SKETCH Scale 1:50

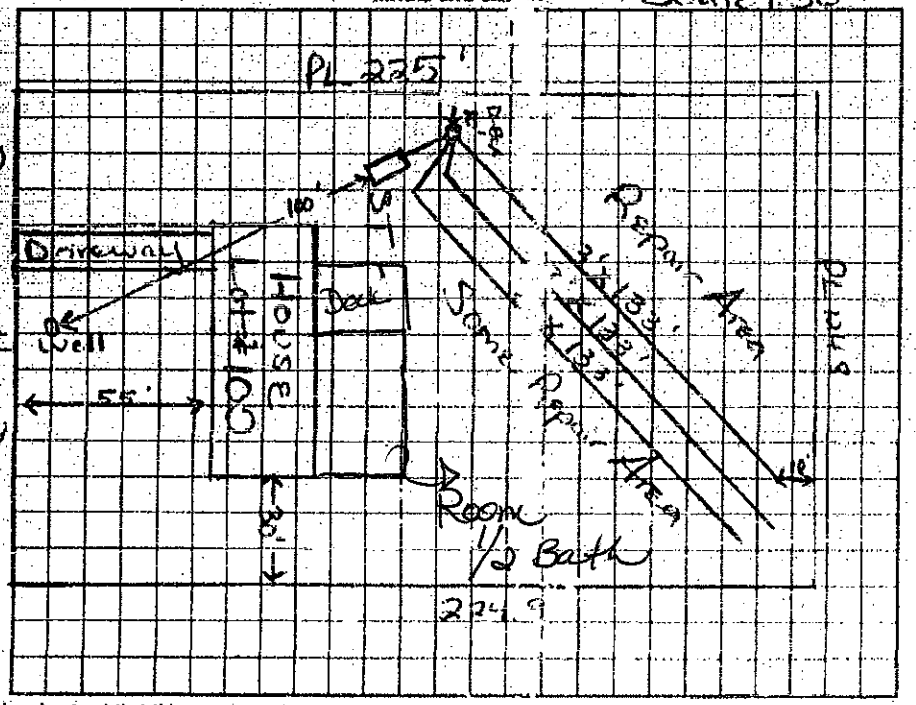

AS BUILT SKETCH

The proposed / existing Room and Deck addition does not appear to impact the existing septic system.
**NOTE: Mountain all setbacks

Keith Cook R.S.
Date: 11-16-09
ICHD-Environmental Health Division

Installed as shown

I understand that this permit can be suspended or revoked if any false information is supplied toward securing the permit/any unauthorized changes are made to the site/any unauthorized changes are made in the installation of the system. Improvement Permit with plat valid without expiration. Improvement Permit with site plan valid for sixty months. Authorization to Construct is valid for a period equal to that of Improvement Permit – not to exceed sixty months.

Signed: ____ date ____

Improvement Permit by: Maria H H Dotson date 3/20/98

Authorization to Construct by: STEVE HENDRICK date 10/15/98

Installed by: Tommy Fipe

Operation Permit by: [illegible] date 3-19-99

Existing System Inspection by: ____ date ____

HEALTH DEPT COPY WHITE INSPECTION COPY (FINAL) GREEN OWNER COPY (FINAL) YELLOW INSPECTION COPY (INITIAL) PINK OWNER COPY (INITIAL) GOLD

JAN. 4, 1989 23:36

Rumple Hill Dr.