(C1) Replaces Permit issued 28 August 07

IREDELL COUNTY HEALTH DEPARTMENT

STATESVILLE 704-878-5305 MOORESVILLE 704-664-5281

IMPROVEMENT PERMIT / AUTHORIZATION TO CONSTRUCT / OPERATION PERMIT / EXISTING SYSTEM INSPECTION

PERMIT# 133869 PIN# 4722-59-0730 DATE 11 October 07

OWNER OR APPLICANT Noble B. Mills, II PHONE: Business Home 704-528-5013

ADDRESS 366 Lippard Springs Circle Statesville, N.C. 28677

LOCATION Buffalo Shoals Rd. Turn Buffalo Creek Dr. 3rd lot on left.

SUBDIVISION Buffalo Creek BLOCK / SECTION LOT 3 LOT AREA 2.13 Ac. SITE CLASS. PS DESIGN FLOW 360 g/d L.T.A.R. 0.36/FH ft.

Septic Tank: 1500 Gallons; STB TP-150 STB 338 Date 7-27-07

Pump Tank: Gallons; PT Date

Pump Make: Model Serial No.

Nitrification Field: No Fields 1 Square Feet 1200 Linear Feet 300

No Lines Trench Width 36" Max Trench Bottom Depth 33" Gravel Depth Gravity ☐ Pressure

☑ New System ☐ Repair ☐ Expansion System Type: I II III IV V VI

System Description: 0.25% Reduction System

Repair System Description: 25% Reduction System.

Maintenance Agreement Required: ☐ Yes ☐ No

☑ House/Mod. Home No. Bedrooms 3

☐ Mobile Home No. Persons

☐ Business No. Employees

☐ Other

Water Supply: ☑ Individual ☐ Public ☐ Community

☐ Slab ☑ Crawl Space ☐ Basement w/plumbing ☐ Basement wo/plumbing

Comments:/Conditions:

Comments:/Conditions: Filter installed.

INITIAL SITE SKETCH

* See Attached "Fast Track" Site plan prepared by Steve Reid Soil & Environmental Consultants. Site plan modified 11 October after redraw request.

AS BUILT SKETCH

Installed as Drawn on Site plan

Permit can be suspended or revoked if any false information is supplied toward securing the permit/any unauthorized changes are made to the site/any unauthorized changes are made in the installation of the system. Improvement Permit with plat valid without expiration ☐ Improvement Permit with site plan valid for sixty months ☑ Authorization to Construct is valid for a period equal to that of Improvement Permit – not to exceed sixty months.

Signed: Randy E Broome date

Improvement Permit by: D. Higgins, R.S. date 11 Oct. 07

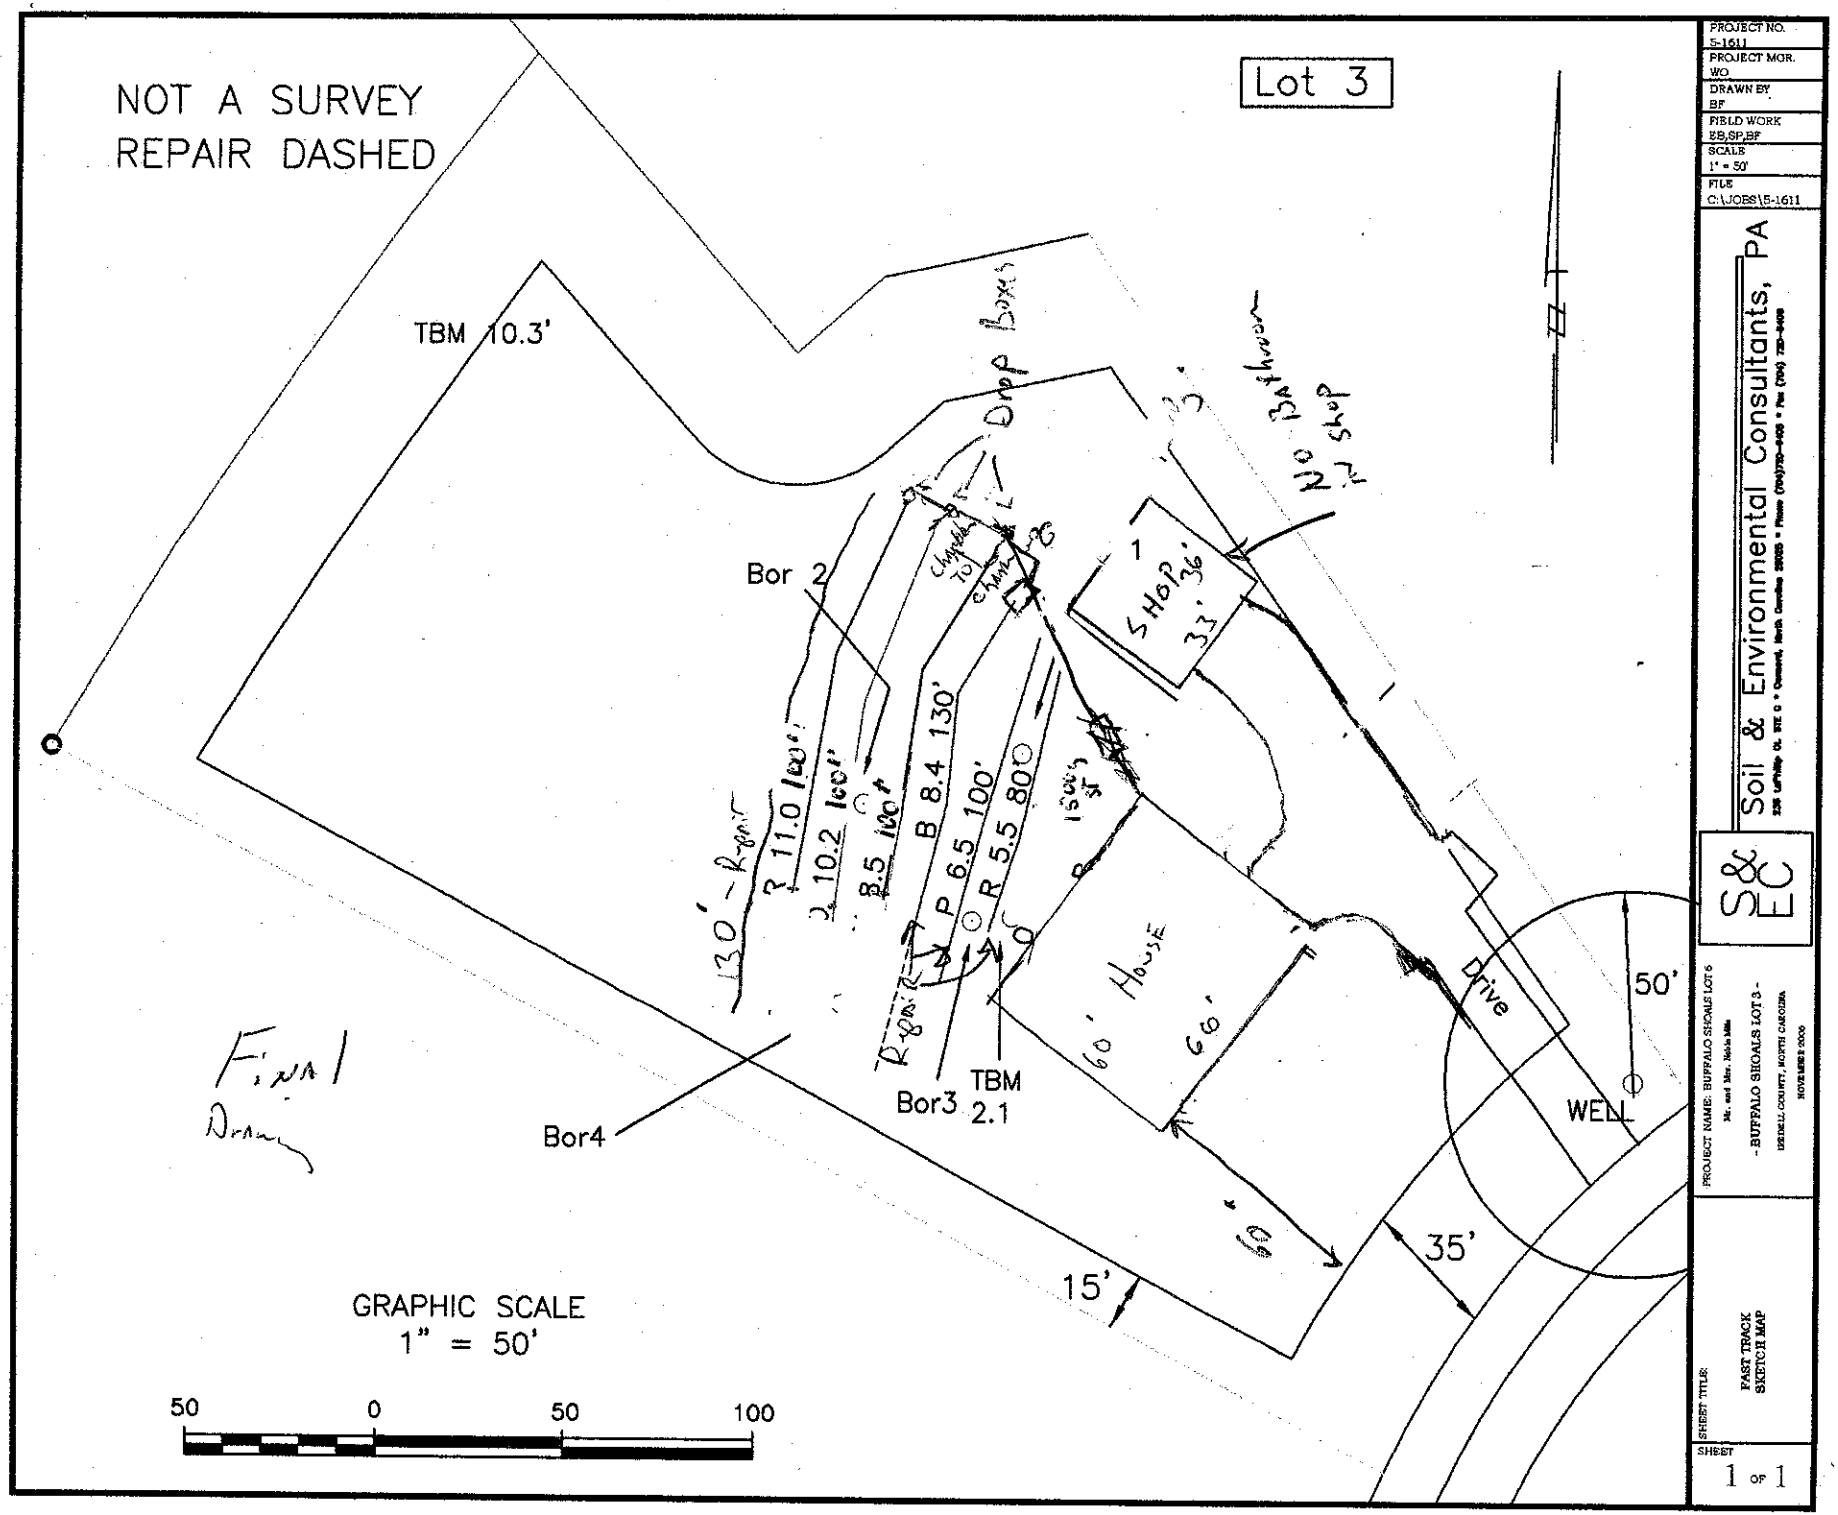
Authorization to Construct by: D. Higgins, R.S. date 11 Oct. 07

Installed by: Lynn Frye

Operation Permit by: D. Higgins, R.S. date 7 Feb. 08

Existing System Inspection by: date

HEALTH DEPT. COPY: WHITE OWNER COPY (FINAL): YELLOW OWNER COPY (INITIAL): PINK


NOT A SURVEY
REPAIR DASHED
Lot 3
TBM 10.3'
Drop Box
Bathroom
No shop
Bor 2
1 Shop 33' 36'
B 8.4 130'
P 6.5 100'
R 5.5 80'
130' - Right
? 11.0 100'
? 10.2 100'
8.5 100'
60' House
60'
Drive
50'
WELL
TBM 2.1
Bor3
Bor4
Final Drawing
35'
15'
GRAPHIC SCALE
1" = 50'
50 0 50 100
PROJECT NO. 5-1611
PROJECT MGR. WO
DRAWN BY BF
FIELD WORK EB,SP,BF
SCALE 1" = 50'
FILE C:\JOBS\5-1611
Soil & Environmental Consultants, PA
S&EC
PROJECT NAME: BUFFALO SHOALS LOT 6
Mr. and Mrs. Nelda Mills
- BUFFALO SHOALS LOT 3 -
IREDELL COUNTY, NORTH CAROLINA
NOVEMBER 8 2000
SHEET TITLE:
FAST TRACK SKETCH MAP
SHEET 1 OF 1