IREDELL COUNTY HEALTH DEPARTMENT

Statesville Office (704) 878-5305 Mooresville Office (704) 660-3625 PERMIT # 177797

IMPROVEMENT PERMIT / AUTHORIZATION TO CONSTRUCT / OPERATION PERMIT / EXISTING SYSTEM

PIN # 4722594082 + 4722597116

APPLICANT: CMH Homes APPLICANT ADDRESS: P.O. Box 9790 / Maryville, TN 37801

SITE ADDRESS: 241 Winding Cedar Statesville, NC 28677 PHONE: 704 239 3693 ALT. PHONE:

SITE DIRECTIONS: (L) on Buffalo shoals (L) on Davidson Rd - (R) on Winding Cedar Dr. - to very end - lot in cul-de-sac

SUBDIVISION: ~~Winding Cedar~~ Davidson Woods SECTION: 3 LOT #49+50 LOT AREA: 2.86 total DESIGN FLOW: 360 L.T.A.R.: .25

Septic Tank 1000 (gal) STB 760 Date 5-12-13
Pump Tank (gal) PT Date
Pump Make Model Serial #
Nitrification Fields 1 # Lines 2 @ 4 Linear Ft: 2 @ 90' 360
Trench Width 36" Max. Trench Bottom Depth 36" Gravel Depth n/a

☒ New System ☐ Repair ☐ Expansion System Type: I II III IV V VI
System Description: 25% Reduction Gravity
Repair System Description: 50% Reduction LP
Maintenance Agreement Required: ☐ YES ☒ NO
☒ GRAVITY ☐ PRESSURE


☒ Residence No. Bedrooms 3
☐ Business No. Persons
☐ Other No. Employees
☐ Slab ☐ Crawl Space
☒ Basement w/plumbing ☐ Basement w/o plumbing

Water Supply: ☒ Private ☐ Public ☐ Community


Comments / Conditions:

Lot 49 + 50 must be ~~record~~ combined, or a legal easement recorded before OP will be issued. lot 49 has offsite easement for repair

INITIAL SITE SKETCH

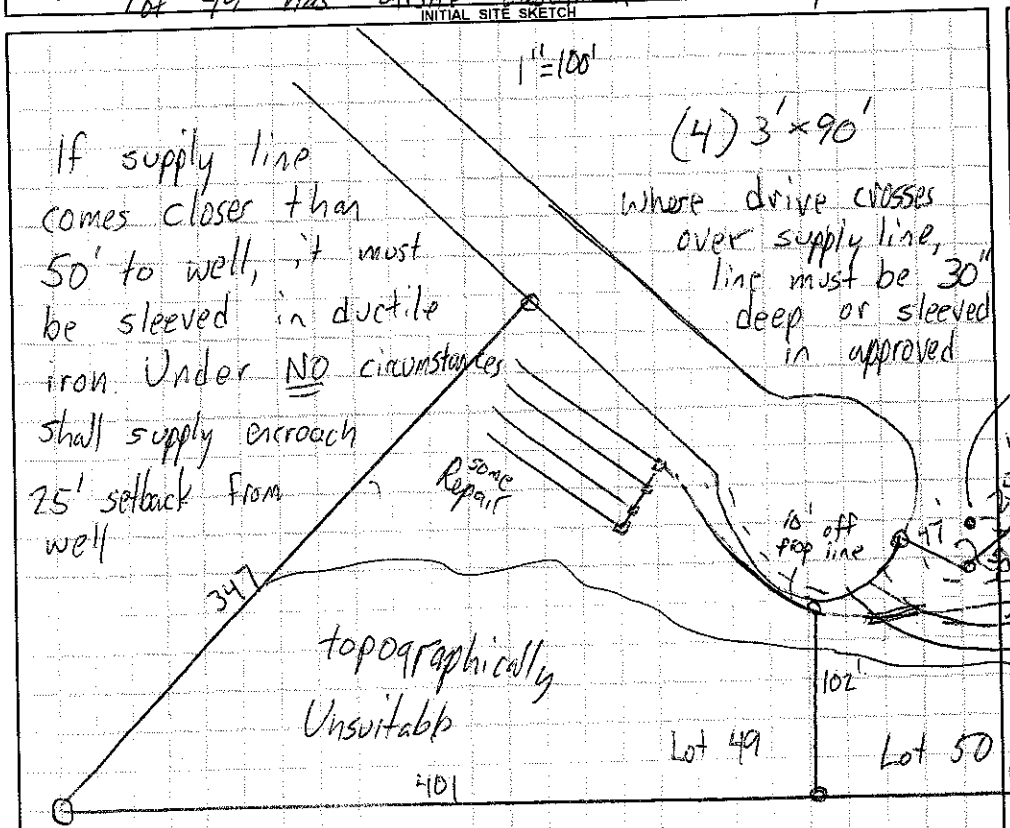

AS BUILT SKETCH

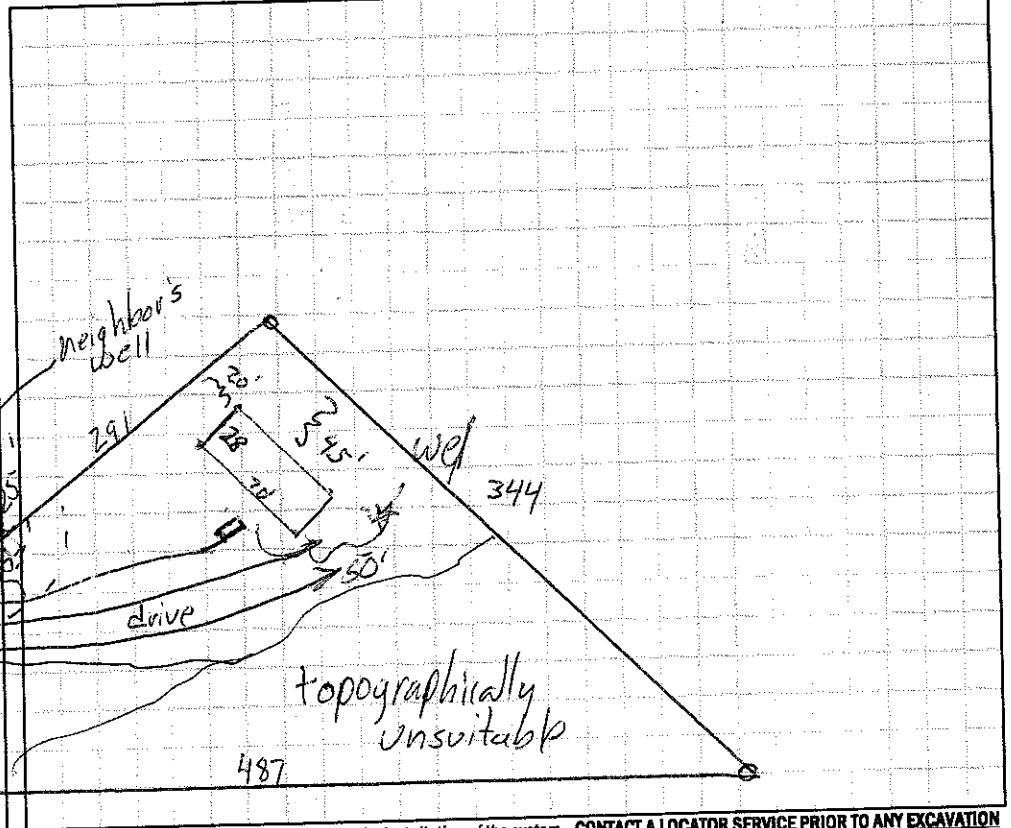

CONTACT A LOCATOR SERVICE PRIOR TO ANY EXCAVATION

Permit can be suspended or revoked if any false information is supplied toward securing the permit / any unauthorized changes are made to the site / any unauthorized changes are made in the installation of the system.

☐ **IMPROVEMENT PERMIT** *with plat* valid without expiration. ☒ **IMPROVEMENT PERMIT** *with site plan* valid for 60 mos. ☐ **AUTHORIZATION TO CONSTRUCT** valid for period equal to IMPROVEMENT PERMIT--not to exceed 60 mo.

Owner / Applicant Signature: Date: 4/17/13 Installed by: Akers Grading

IMPROVEMENT PERMIT by: Date: 4-17-13 OPERATION PERMIT by: Date: 10-1-13

AUTHORIZATION TO CONSTRUCT by: Date: 8-13-13 Existing System Inspected by: Date:

Health Dept. Copy - WHITE Applicant (Final Approval) - YELLOW Applicant (Conditional Approval) - PINK