IREDELL COUNTY HEALTH DEPARTMENT

STATESVILLE 704-878-5305 MOORESVILLE 704-664-5281

IMPROVEMENT PERMIT / AUTHORIZATION TO CONSTRUCT / OPERATION PERMIT / EXISTING SYSTEM INSPECTION

PERMIT# 139091 PIN# 4722-59-4422 DATE 2-1-07

OWNER OR APPLICANT NOBLE B. MILLS II PHONE: Business Home 704-528-5013

ADDRESS 226 LIPPARD SPRINGS CIR STATESVILLE, NC 28677

LOCATION BUFFALO SHOALS ROAD, TL BUFFALO CREEK DRIVE, 5TH LOT ON RIGHT

SUBDIVISION BUFFALO CREEK BLOCK / SECTION LOT 12 LOT AREA 2.06 ACRES SITE CLASS. PS DESIGN FLOW 480 L.T.A.R. 0.30 GPD/FT²

Septic Tank: 1500 Gallons; STB 912 Date 7-5-07
Pump Tank: 1500 Gallons; PT 46 Date 6-19-07
Pump Make: ZOELLNER Model M-153 Serial No.
Nitrification Field: No Fields 1 Square Feet EQ/T 1600 Linear Feet 400
No Lines THREE Trench Width 36" Max Trench Bottom Depth 24"

☑ New System ☐ Repair ☐ Expansion System Type: I II III IV V VI
System Description: 25% REDUCTION, PUMP
Repair System Description: 25% REDUCTION, PUMP
Maintenance Agreement Required: ☐ Yes ☑ No
Gravel Depth N/A ☐ Gravity ☑ Pressure ☐ Slab ☑ Crawl Space ☐ Basement w/plumbing ☐ Basement wo/plumbing

☑ House/Mod. Home No. Bedrooms 4
☐ Mobile Home No. Persons
☐ Business No. Employees
☐ Other

Water Supply: ☑ Individual ☐ Public ☐ Community WELL

Comments/Conditions: INSTALL 25% REDUCTION SYSTEM ON CONTOUR NO DEEPER THAN 24 INCHES. SEE ATTACHED SHEETS FOR PUMP & PRESSURE MANIFOLD REQUIREMENTS

Comments/Conditions: 3-7-07 OK'D 52 x 46 HOUSE PLAN w/ 4 BEDROOM, WITH PARTIAL BASEMENT DRAWN IN. TANKS MAY BE MOVE TOWARD WELL BUT 50' SETBACK MUST BE MAINTAINED. DO NOT MOVE TANKS DOWN OR LOWER ANY. ONLY ALLOWED TO MOVE EAST TOWARD WELL SETBACK, NOT ENCROACHING INTO THE 50' SETBACK.

INITIAL SITE SKETCH

SEE ATTACHED "FAST TRACK" SITE PLAN PREPARED BY STEVE PRICE SOIL & ENVIRONMENTAL CONSULTANTS, PA

AS BUILT SKETCH

Blue FLAG

L1=33
L2=33
L3=34


NOT CORRECT RECEIVED ON 2-27-08 & CHECKED & FOUND FLAWS

PERMIT WAS EXPIRED & LATER FAXED

Permit can be suspended or revoked if any false information is supplied toward securing the permit/any unauthorized changes are made to the site/any unauthorized changes are made in the installation of the system. Improvement Permit with plat valid without expiration ☐ Improvement Permit with site plan valid for sixty months ☑ Authorization to Construct is valid for a period equal to that of Improvement Permit – not to exceed sixty months.

Signed: Noble B. Mills II date 2-2-07
Improvement Permit by: STEVE HEDRICK date 2-1-07
Authorization to Construct by: date 3-7-07
Installed by: Rountree Septic
Operation Permit by: date 10/18/07
Existing System Inspection by: date

HEALTH DEPT. COPY: WHITE OWNER COPY (FINAL): YELLOW OWNER COPY (INITIAL): PINK

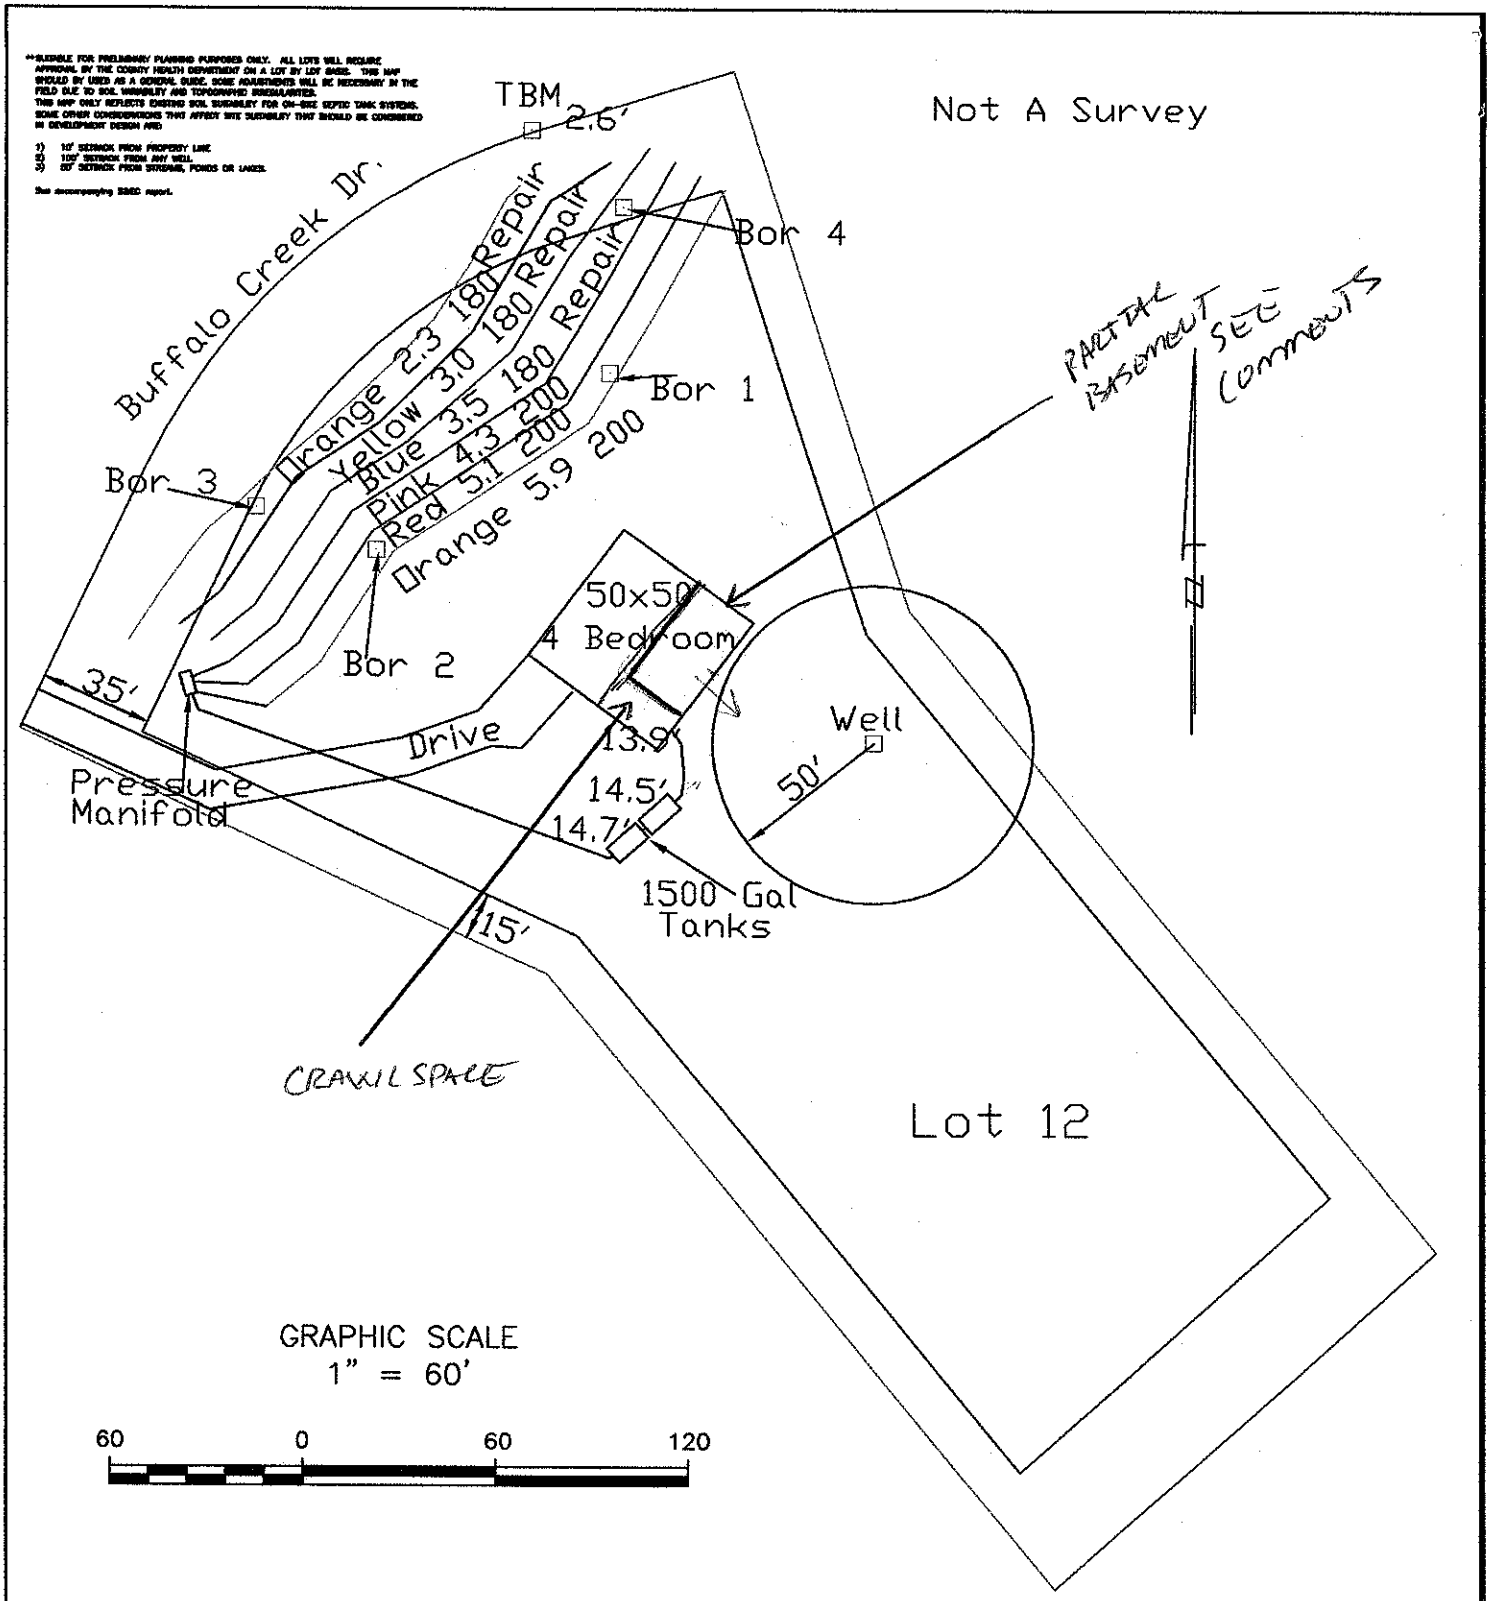

SHEET 1 OF 1	SHEET TITLE: Fast Track Site Plan SKETCH MAP	PROJECT NAME: Buffalo Shoals Sandy Mills - BUFFALO SHOALS- IREDELL COUNTY, NORTH CAROLINA NOV 2006	S&EC	Soil & Environmental Consultants, PA 636 LaPhilip Ct, Ste C Concord, North Carolina 28025 = Phone (704)720-9405 = Fax (704) 720-9406	FILE: Y:\Jobs\05-161	SCALE: 1" = 60'	FIELD WORK BY: SS, SP, BP	DRAWN BY: BP	PROJECT MGR.: SP	PROJECT NO.: 5-161