IREDELL COUNTY HEALTH DEPARTMENT

STATESVILLE 704-878-5305 (CL) MOORESVILLE 704-664-5281

IMPROVEMENT PERMIT / AUTHORIZATION TO CONSTRUCT / OPERATION PERMIT / EXISTING SYSTEM INSPECTION

PERMIT# 139085 PIN# 4722 59 [redacted] 7991 DATE 1 December 06

OWNER OR APPLICANT Noble B. Mills, II PHONE: Business 704-528-5013 Home 704-528-5013

ADDRESS 226 Lippard Springs Circle, Statesville, N.C. 28677

LOCATION Buffalo Creek Rd., 6th Lot on Left

SUBDIVISION Buffalo Creek BLOCK / SECTION ____ LOT 6 LOT AREA 0.99 Ac. SITE CLASS PS DESIGN FLOW 480 gpd L.T.A.R. 0.3 gal/ft²/day

Septic Tank: 1000 Gallons; STB 1012 Date 2-13-2007
Pump Tank: ____ Gallons; PT ____ Date ____
Pump Make: ____ Model ____ Serial No. ____
Nitrification Field: No Fields 1 Square Feet 1680 Linear Feet 420
No Lines 3 Trench Width 3' Max Trench Bottom Depth 28" Gravel Depth ____

☑ New System ☐ Repair ☐ Expansion System Type: I (II) III IV V VI
System Description: 25% Reduction
Repair System Description: 25% Reduction
Maintenance Agreement Required: ☐ Yes ☑ No

☑ House/Mod. Home No. Bedrooms 4
☐ Mobile Home No. Persons ____
☐ Business No. Employees ____
☐ Other ____

Water Supply: ☑ Individual ☐ Public ☐ Community

☑ Gravity ☐ Pressure ☐ Slab ☑ Crawl Space ☐ Basement w/plumbing ☐ Basement wo/plumbing

Comments:/Conditions: MAX trench depth 28" Keep up slope as far as possible

Comments:/Conditions: SEPTIC TANK W/ MARKER INSTALLED USING "TUFFTITE" FILTER.

INITIAL SITE SKETCH

* Refer to Aff soil/site plan and evaluation.
* House location changed 29 JAN. 07. System area remains unchanged.

AS BUILT SKETCH

SYSTEM INSTALLED ACCORDING TO SITE PLAN


Permit can be suspended or revoked if any false information is supplied toward securing the permit/any unauthorized changes are made to the site/any unauthorized changes are made in the installation of the system. Improvement Permit with plat valid without expiration ☐ Improvement Permit with site plan valid for sixty months ☑ Authorization to Construct is valid for a period equal to that of Improvement Permit – not to exceed sixty months.

Signed: /s/ Noble B. Mills, II date 12-8-06
Improvement Permit by: Jim Wiggs, R.S. date 1 Dec. 06
Authorization to Construct by: Jim Wiggs, R.S. date 29 JAN. 07

Installed by: DAVID YOWTE
Operation Permit by: STEVE HEDRICK date 8-6-07
Existing System Inspection by: ____ date ____

HEALTH DEPT. COPY: WHITE OWNER COPY (FINAL): YELLOW OWNER COPY (INITIAL): PINK

NOT A SURVEY

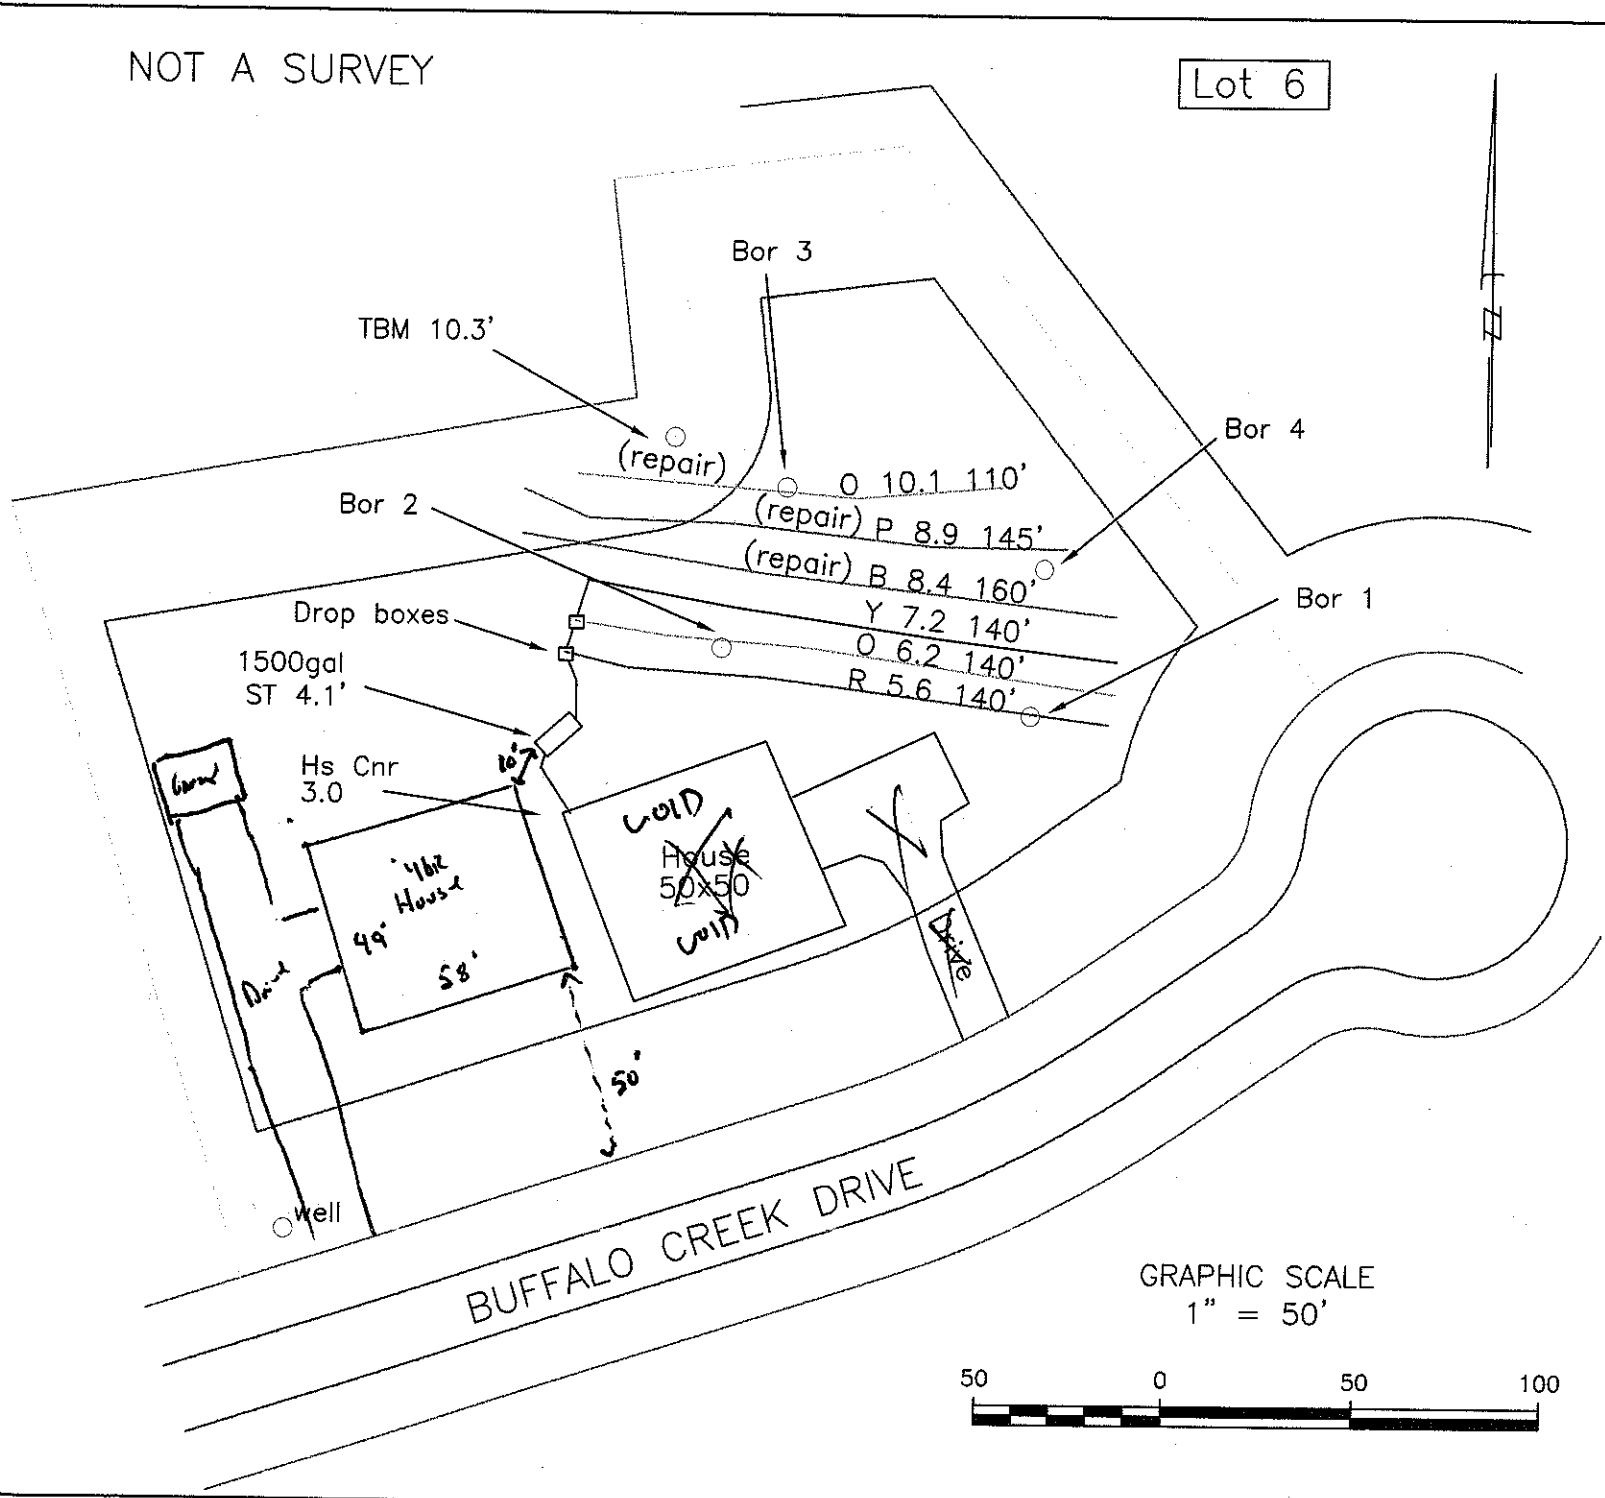

PROJECT NO. 5-1611
PROJECT MGR. WO
DRAWN BY BF
FIELD WORK EB,SP,BF
SCALE 1" = 50'
FILE C:\JOBS\5-1611

Soil & Environmental Consultants, PA
239 Mallard St. STE C • Concord, North Carolina 28025 • Phone (704)720-6406 • Fax (704) 720-6406

S&EC

PROJECT NAME: BUFFALO SHOALS LOT 6
Mr. and Mrs. Bobbie Mills
- BUFFALO SHOALS LOT 6 -
IREDELL COUNTY, NORTH CAROLINA
NOVEMBER 2006

SHEET TITLE: FAST TRACK SKETCH MAP

SHEET 1 OF 1