IREDELL COUNTY HEALTH DEPARTMENT

STATESVILLE 704-878-5305 MOORESVILLE 704-664-5281

IMPROVEMENT PERMIT / CERTIFICATE OF COMPLETION / OPERATION PERMIT / EXISTING SYSTEM INSPECTION

PROPERTY DESCRIPTION NO. 26287 DATE 4-3-97 TAX MAP NO. 4722 64 3527 Watershed: ☑ Yes ☐ No

OWNER OR CONTRACTOR John McGinty PHONE: Business Home 528-4732

ADDRESS 651 old mocksville Rd Statesville

LOCATION US 21 South TR old mtn Rd before Kyles X Rd Tr NEW ST. 1500' off Rd

SUBDIVISION BLOCK / SECTION LOT LOT AREA 26 acres SITE CLASS. PS DESIGN FLOW 480 T.A.R. 4

Septic Tank: 1000 Gallons; STB 1013 Date 2-7-97

Pump Tank: Gallons; PT Date

Pump Make: Model Serial No.

Nitrification Field: No Fields 1 Square Feet 1800 Linear Feet 600

No Lines 6 Trench Width 36" Max Trench Bottom Depth 36" Gravel Depth 12"

☑ New System ☐ Repair System Type: I, II, III, IV, V, VI

System Description: Conv. Gravity

Repair System Description: " "

Maintenance Agreement Required: ☐ Yes ☐ No

☑ House/Mod. Home ☐ Mobile Home ☐ Business ☐ Other

No. Bedrooms 4 No. Bathrooms 3 No. Employees


☐ Slab ☐ Crawl Space ☑ Basement w/plumbing ☐ Basement wo/plumbing

Water Supply: ☑ Individual ☐ Community ☐ Public


Comments:

Comments:

INITIAL SITE SKETCH

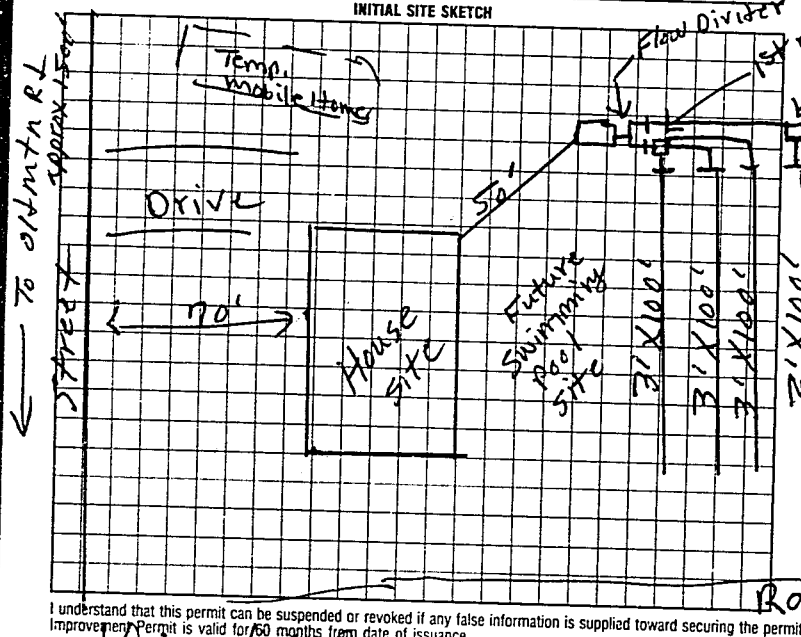

AS BUILT SKETCH

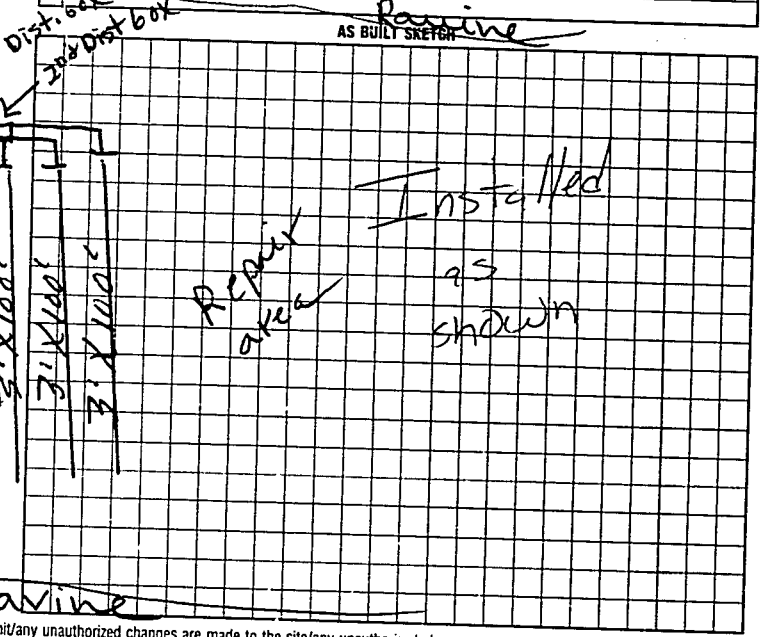

I understand that this permit can be suspended or revoked if any false information is supplied toward securing the permit/any unauthorized changes are made to the site/any unauthorized changes are made in the installation of the system. Improvement Permit is valid for 60 months from date of issuance.

Signed: Linda H. McGinty

Improvement Permit by: L. C. Moore date 4-3-97

Authorization to Install Existing System Inspection by: L. C. Moore date 4-3-97

Installed by: A-1 Backhoe

Certificate of Completion by: date

Operation Permit by: Mark Ortz RS date 4-15-97

PINK DEPT. COPY (WHITE) INSPECTION COPY (FINAL) GREEN OWNER COPY (FINAL) YELLOW INSPECTION COPY (INITIAL) PINK OWNER COPY (INITIAL) GOLD

To cond. Authorization to cond. Expires 60 mos from issue