IREDELL COUNTY HEALTH DEPARTMENT

STATESVILLE 704-878-5305 MOORESVILLE 704-664-5281

IMPROVEMENT PERMIT / CERTIFICATE OF COMPLETION / OPERATION PERMIT / EXISTING SYSTEM INSPECTION

PROPERTY DESCRIPTION NO. 26287 DATE 4-3-97 TAX MAP NO. 4722 64 3527 Watershed: ☒ Yes ☐ No

OWNER OR CONTRACTOR John McGinty PHONE: Business Home 528-4722 COSTIV PA

ADDRESS 651 Old Mocksville Rd Statesville

LOCATION US 21 South TR Old Mocksville Rd before Kyles Xrd The New St. 1500' off Rd

SUBDIVISION BLOCK / SECTION LOT LOT AREA 2½ acres SITE CLASS PS DESIGN FLOW T.A.R. 3

Septic Tank: 1000 Gallons; STB 1012 Date 2-7-97

Pump Tank: Gallons; PT Date

Pump Make: Model Serial No.

Nitrification Field: No Fields 1 Square Feet 1800 Linear Feet 600

No Lines 6 Trench Width 36" Max Trench Bottom Depth 36" Gravel Depth 12"

☒ New System ☐ Repair System Type: I, II, III, IV, V, VI

System Description: Conv. Gravity

Repair System Description:

Maintenance Agreement Required: ☐ Yes ☐ No

☒ House/Mod. Home ☐ Mobile Home ☐ Business ☐ Other

No. Bedrooms 4 No. Bathrooms 3 No. Employees


Water Supply: ☒ Individual ☐ Community ☐ Public

☐ Slab ☐ Crawl Space ☒ Basement w/plumbing ☐ Basement wo/plumbing

Comments:


40'

INITIAL SITE SKETCH

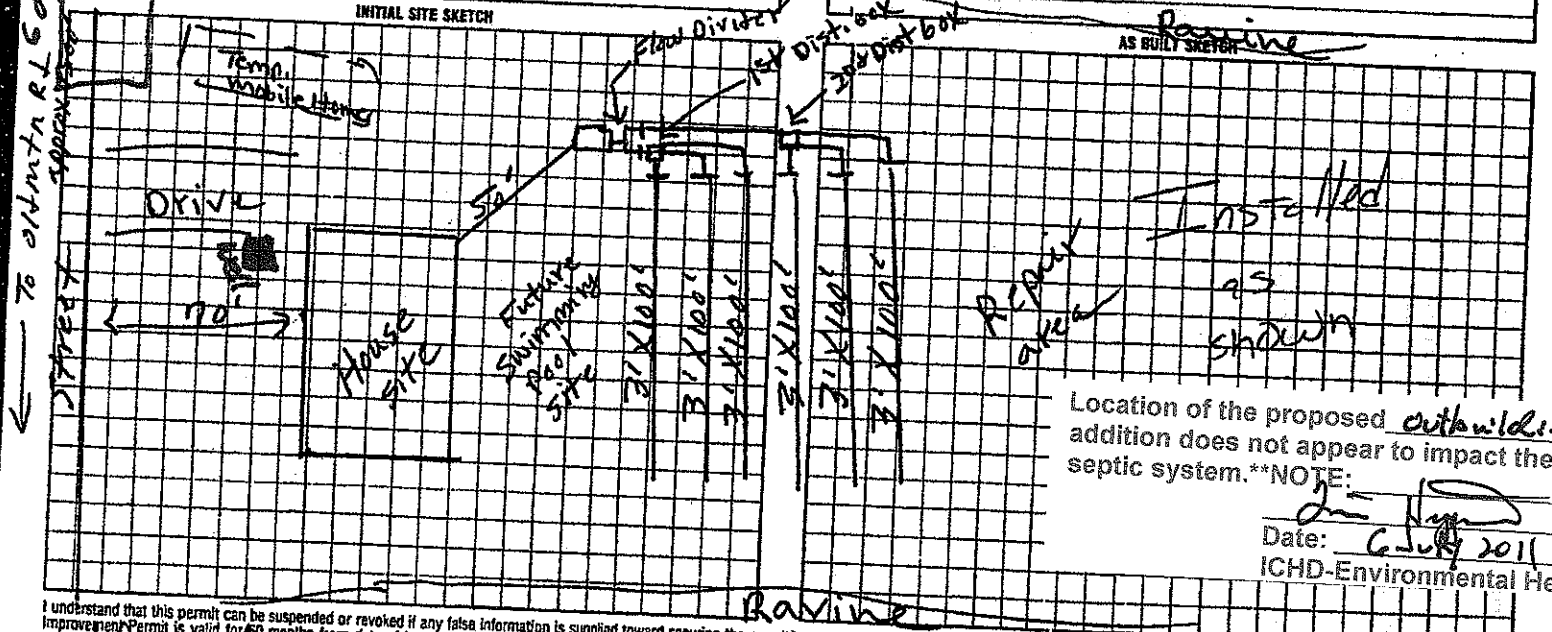

Comments:

AS BUILT SKETCH Ravine

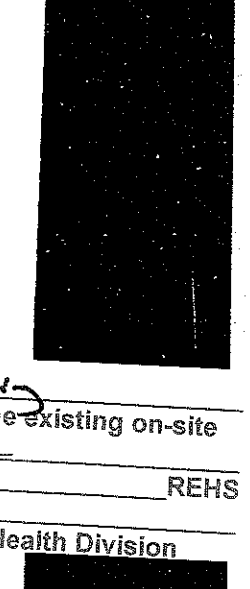

Location of the proposed outbuilding addition does not appear to impact the existing on-site septic system.**NOTE:

Date: 6 July 2011 REHS

ICHD-Environmental Health Division

I understand that this permit can be suspended or revoked if any false information is supplied toward securing the permit/any unauthorized changes are made to the site/any unauthorized changes are made in the installation of the system. Improvement Permit is valid for 60 months from date of issuance.

Signed: Linda H. McGinty

Improvement Permit by: L. E. Osborne date 4-3-97

Authorization to Construct by: L. E. Moore date 4-3-97

Installed by: A-1 Backhoe

Certificate of Completion by: date

Operation Permit by: Mark Ozment date 4-5-97

YELLOW DEPT. COPY WITH IMPROVEMENT PERMIT GREEN INSPECTION COPY (FINAL) YELLOW OWNER COPY (FINAL) PINK INSPECTION COPY (INITIAL) PINK OWNER COPY (INITIAL) GOLD

Authorization to Const. Expires 60 mos from issue

6 2 0 1 0