IREDELL COUNTY HEALTH DEPARTMENT

STATESVILLE 704-878-5305 MOORESVILLE 704-664-5281

IMPROVEMENT PERMIT / AUTHORIZATION TO CONSTRUCT / OPERATION PERMIT / EXISTING SYSTEM INSPECTION

PERMIT# 96102 PIN# 4722 66 0462 DATE 8-28-98

OWNER OR CONTRACTOR Chris Davidson PHONE: Business 8729579 Home

ADDRESS PO Box 252 Statesville 138 st. martins Ln.

LOCATION Old Mtn Rd Turn Rumple Hill Rd TR st martins Ln on Rt.

SUBDIVISION Lippard Sp. BLOCK / SECTION LOT 19 LOT AREA x81 SITE CLASS. PS DESIGN FLOW 360 L.T.A.R. .25

Septic Tank: 1000 Gallons; STB 55 Date 7-31-98

Pump Tank: Gallons; PT Date

Pump Make: Model Serial No.

Nitrification Field: No Fields 1 Square Feet 1080 Linear Feet 360

No Lines 5 Trench Width 36" Max Trench Bottom Depth 36" Gravel Depth N/A

[x] New System [ ] Repair System Type: I, II, III, IV, V, VI

System Description: Gravity 25% Rct.

Repair System Description:

Maintenance Agreement Required: [ ] Yes [x] No

[x] House/Mod. Home No. Bedrooms 3

[ ] Mobile Home No. Bathrooms 2

[ ] Business No. Employees

[ ] Other


[ ] Slab [ ] Crawl Space [ ] Basement w/plumbing [ ] Basement wo/plumbing

Water Supply: [x] Individual [ ] Public [ ] Community


Comments:/Conditions:

Comments:/Conditions: sch HP

INITIAL SITE SKETCH

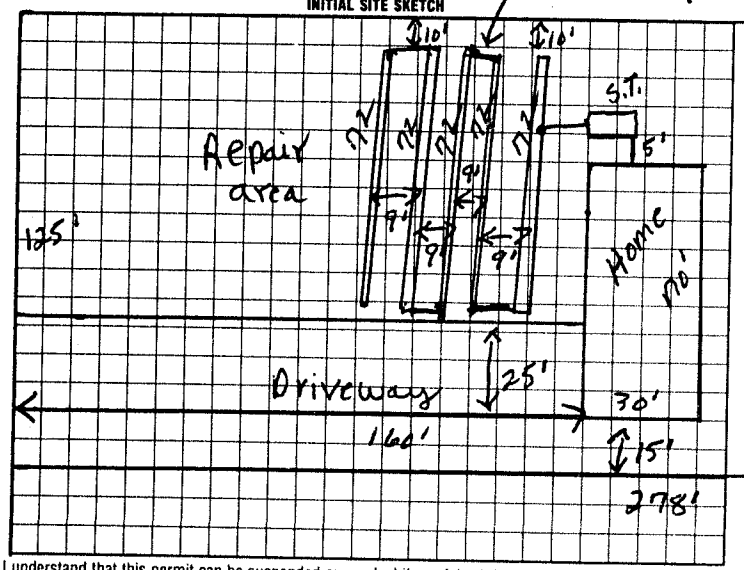

AS BUILT SKETCH

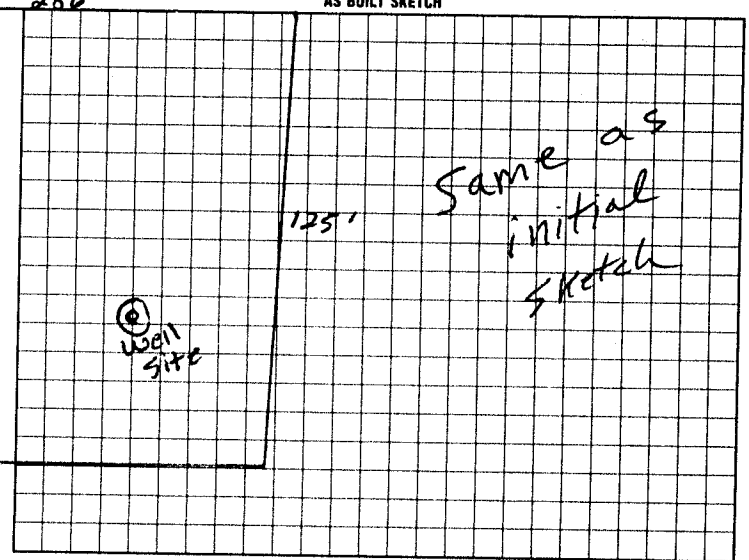

I understand that this permit can be suspended or revoked if any false information is supplied toward securing the permit/any unauthorized changes are made to the site/any unauthorized changes are made in the installation of the system. Improvement Permit with plat valid without expiration. Improvement Permit with site plan valid for sixty months. Authorization to Construct is valid for a period equal to that of Improvement Permit – not to exceed sixty months.

Signed: Neal Kale date 9-8-98 Installed by: Charlie Brice

Improvement Permit by: L. C. Moore date 8-28-98 Operation Permit by: L. C. Moore date 1-22-99

Authorization to Construct by: L. C. Moore date 8-28-98 Existing System Inspection by: date

HEALTH DEPT. COPY: WHITE INSPECTION COPY (FINAL) GREEN OWNER COPY (FINAL) YELLOW INSPECTION COPY (INITIAL) PINK OWNER COPY (INITIAL) GOLD