IREDELL COUNTY HEALTH DEPARTMENT

STATESVILLE 704-878-5305 (2) MOORESVILLE 704-664-5281

IMPROVEMENT PERMIT / AUTHORIZATION TO CONSTRUCT / OPERATION PERMIT / EXISTING SYSTEM INSPECTION

PERMIT # 160000 PIN # 4722-66-1051 DATE 3-8-10

OWNER or APPLICANT Joseph Gentle PHONE: Business Home: 704 902 0559

OWNER or APPLICANT ADDRESS 714 Old Mountain Rd.

LOCATION / DIRECTIONS I-40 West, (L) on Old Mountain Rd past Compton Park road on Left

SUBDIVISION n/a BLOCK / SECTION LOT # ~~n/a~~ 3 LOT AREA .74 DESIGN FLOW 360 L.T.A.R. .35

Septic Tank 1000 Gallons: STB Date

Pump Tank Gallons: P T Date

Pump Make Model Serial #

Nitrification Field No Fields 1 No Lines 2 Linear Feet 260

Trench Width 36" Max. Trench Bottom Depth 36" Gravel Depth n/a

[X] New System [X] Repair [ ] Expansion System Type I II III IV V VI

System Description: 25% Reduction Gravity

Repair System Description: 50% Reduction Pressure

Maintenance Agreement Required [ ] YES [X] NO

[X] GRAVITY [ ] PRESSURE

[X] Residence No. Bedrooms 3 [ ] Business No. Persons [ ] Other No. Employees

[ ] Slab [X] Crawl Space [ ] Basement w/plumbing [ ] Basement w/o plumbing


Water Supply: [X] Private [ ] Public [ ] Community

Comments / Conditions

Detach existing system - (to be used partially for repair) add 2 lines totalling 260' at minimum

Comments / Conditions

INITIAL SITE SKETCH

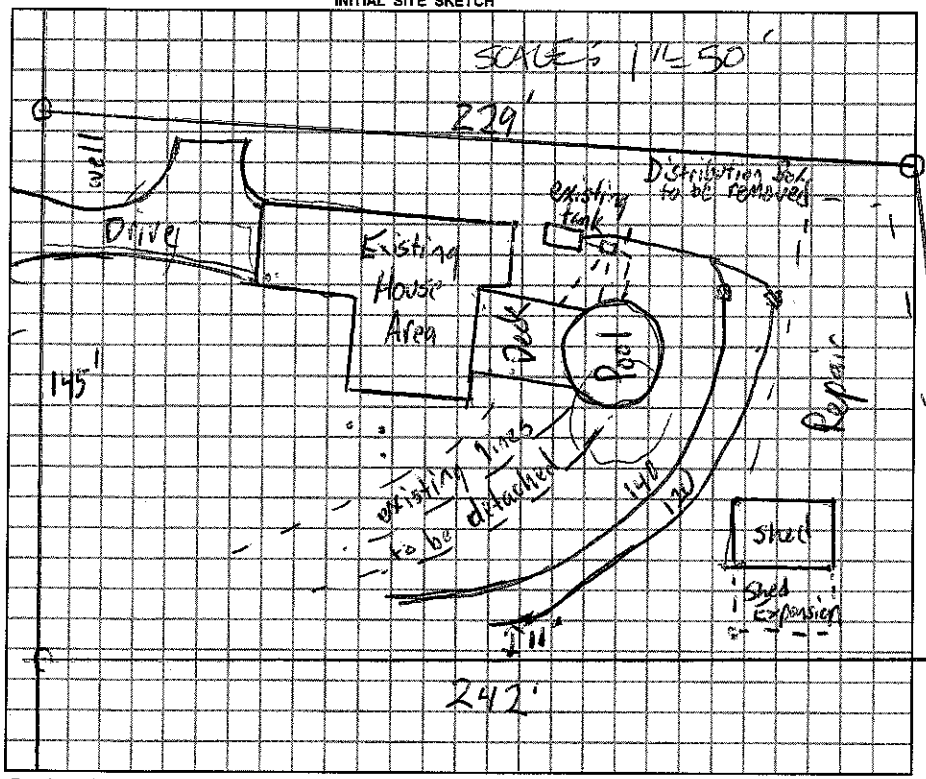

AS BUILT SKETCH

Installed As Drawn.

Permit can be suspended or revoked if any false information is supplied toward securing the permit / any unauthorized changes are made to the site / any unauthorized changes are made in the installation of the system.

[X] *IMPROVEMENT PERMIT w / plat valid without expiration.* [X] *IMPROVEMENT PERMIT w / site plan valid for 60 mos.* [X] *AUTHORIZATION TO CONSTRUCT valid for period equal to IMPROVEMENT PERMIT-not to exceed 60 mo.*

Owner / Applicant Signature: Date

Improvement Permit by: Date 3-8-10

Authorization to Construct by: Date 3-8-10

YOU SHOULD CONTACT A LOCATOR SERVICE PRIOR TO ANY EXCAVATION.

Installed by: A-1 Backhoe

Operation Permit by: , R.S. Date: 9 March 10

Existing System Inspected by: Date:

WHITE COPY Environmental Health YELLOW COPY (Final) Owner / Applicant PINK COPY (Initial) Owner / Applicant