PIN# 4722-66-2619

# IREDELL COUNTY HEALTH DEPARTMENT

STATESVILLE 704-878-5305 MOORESVILLE 704-664-5281

## IMPROVEMENT PERMIT / AUTHORIZATION TO CONSTRUCT / OPERATION PERMIT / EXISTING SYSTEM INSPECTION

PERMIT# 15572 PIN# Tax map 6C-6-A-25 DATE 11-1-93

OWNER OR CONTRACTOR S.S. Haskins PHONE: Business Home 892-7567

ADDRESS St martins Dr.

LOCATION Old mtn Rd Turn Rumple Dr. TR St martins on left before end

SUBDIVISION Lippard Sp. BLOCK / SECTION LOT 25 LOT AREA 125x250 SITE CLASS. PS DESIGN FLOW 360 L.T.A.R. 13

Septic Tank: 1000 Gallons; STB 1012 Date 3-6-98

Pump Tank: 1000 Gallons; PT 17 Date 3-6-98

Pump Make: Hydromatic Model SK40 Serial No.

Nitrification Field: No Fields 1 Square Feet 420 Linear Feet 210

No Lines 3 Trench Width 24" Max Trench Bottom Depth 36" Gravel Depth N/A

☐ New System ☐ Repair System Type: I, II, III, IV, V, VI

System Description: Pressure Dosed Panel

Repair System Description: " " "

Maintenance Agreement Required: ☐ Yes ☑ No

☑ House/Mod. Home No. Bedrooms 3

☐ Mobile Home No. Bathrooms 2

☐ Business No. Employees

☐ Other


☐ Slab ☑ Crawl Space ☐ Basement w/plumbing ☐ Basement wo/plumbing

Water Supply: ☑ Individual ☐ Public ☐ Community


Comments/Conditions:

Comments/Conditions: 48 panels 16 in Each Ditch one 3/16 Hole Per Panel 24" working Heat on each Line

INITIAL SITE SKETCH 250'

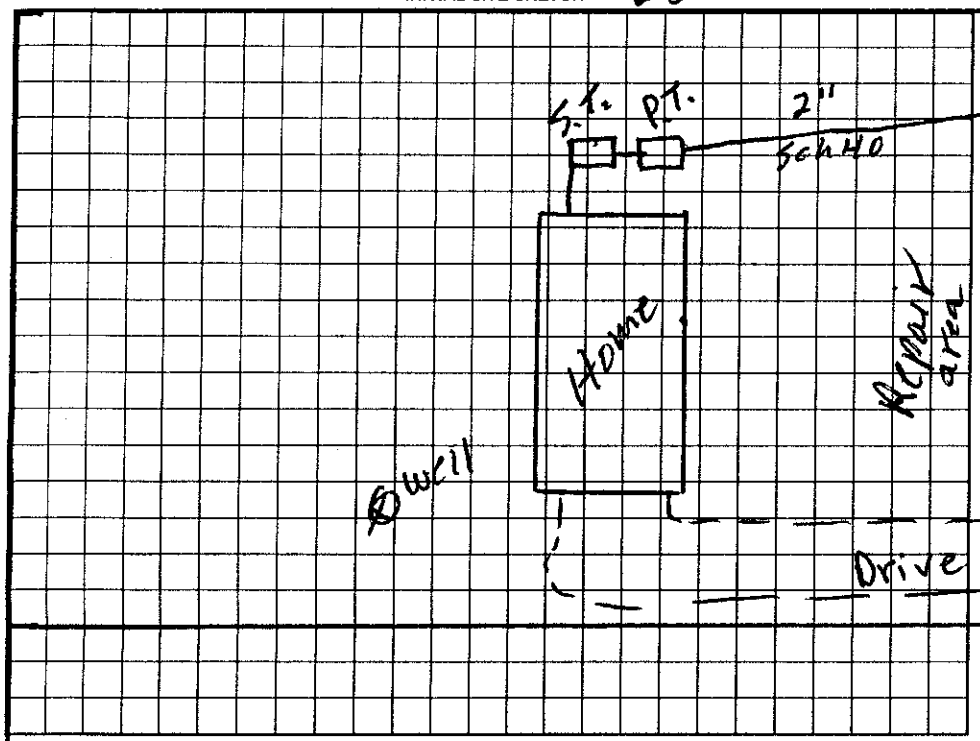


AS BUILT SKETCH

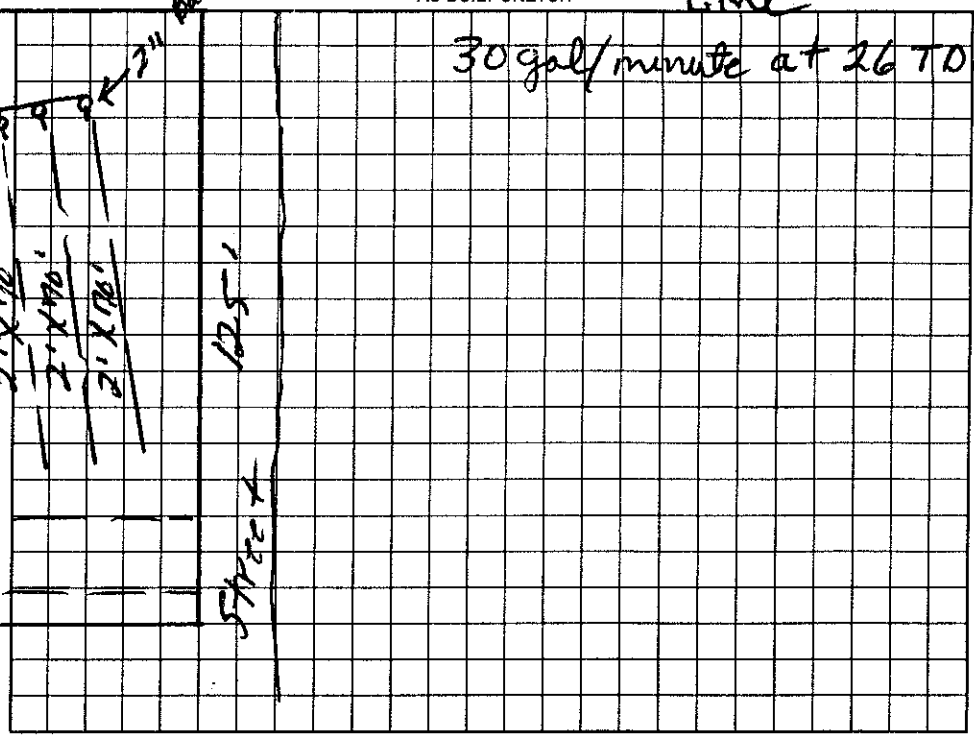


Permit can be suspended or revoked if any false information is supplied toward securing the permit/any unauthorized changes are made to the site/any unauthorized changes are made in the installation of the system. Improvement Permit with plat valid without expiration. Improvement Permit with site plan valid for sixty months. Authorization to Construct is valid for a period equal to that of Improvement Permit – not to exceed sixty months.

Signed: 7 original Permit under Kenneth Beam date Installed by: A-1 Backhoe

Improvement Permit by: michael Dennis date 11-1-93 Operation Permit by: J.C. moore date Oct 1998

Authorization to Construct by: ~~J.C. moore~~ J.C. moore date 3-6-98 Existing System Inspection by: date

HEALTH DEPT COPY: WHITE OWNER COPY (FINAL): YELLOW OWNER COPY (INITIAL): PINK

For SS Haskins