IREDELL COUNTY HEALTH DEPARTMENT

CI

STATESVILLE 704-878-5305 MOORESVILLE 704-664-5281

IMPROVEMENT PERMIT / AUTHORIZATION TO CONSTRUCT / OPERATION PERMIT / EXISTING SYSTEM INSPECTION

PERMIT# 107907 PIN# 4722-67-1638 DATE 09/09/02

OWNER OR CONTRACTOR RW RORIE CONSTRUCTION Co PHONE: Business 704-664-4445 Home

ADDRESS 187 DRUM ST. LINCOLNTON, NC 28092

LOCATION OLD MOUNTAIN RD, (L) RUMPLE HILL DR, (R) LIPPARD SPRINGS CIRCLE, (L) LIPPARD SPRINGS CIRCLE, 4th LOT ON LEFT.

SUBDIVISION LIPPARD SPRINGS BLOCK / SECTION VII LOT 114 LOT AREA 0.60 ACRES SITE CLASS PS DESIGN FLOW 360 GPD L.T.A.R. 0.25

Septic Tank: 1,000 Gallons; STB 821 Date 2-18-05

Pump Tank: 1,000 Gallons; PT 40 Date 1-12-05

Pump Make: ZOELLER Model N137 Serial No. 137-0062

Nitrification Field: No Fields 1 Square Feet EQ to 1,440 Linear Feet 240

No. Lines 6x40' Trench Width 24" Max Trench Bottom Depth 36" Gravel Depth N/A

[X] New System [ ] Repair System Type: I, II, (III), IV, V, VI

System Description: PUMP, 50% REDUCTION

Repair System Description: LOW PRESSURE, 50% REDUCTION

Maintenance Agreement Required: [ ] Yes [X] No

[X] House/Mod. Home [ ] Mobile Home [ ] Business [ ] Other

No. Bedrooms 3 No. Bathrooms 2 No. Employees


[ ] Slab [X] Crawl Space [ ] Basement w/plumbing [ ] Basement wo/plumbing

Water Supply: [X] Individual [ ] Public [ ] Community


Comments/Conditions: (1) INSTALL SUB-SURFACE FRENCH DRAIN AROUND SYSTEM 48" DEEP AROUND SYSTEM, THEN TO DAYLIGHT (2) MAINTAIN ALL SETBACKS INCLUDING FRENCH DRAIN (10' DOWN SLOPE, 15' SIDE, 25' UPSLOPE) (3) INSTALL WELL 100 FEET FROM SYSTEM & KEEP SYSTEM 100 FEET FROM NEIGHBORS WELL. (4) CALL PRIOR TO INSTALLATION FOR PUMP & PRESSURE MANIFOLD INFO.

POLYDYL FILTER & MARKER

INITIAL SITE SKETCH

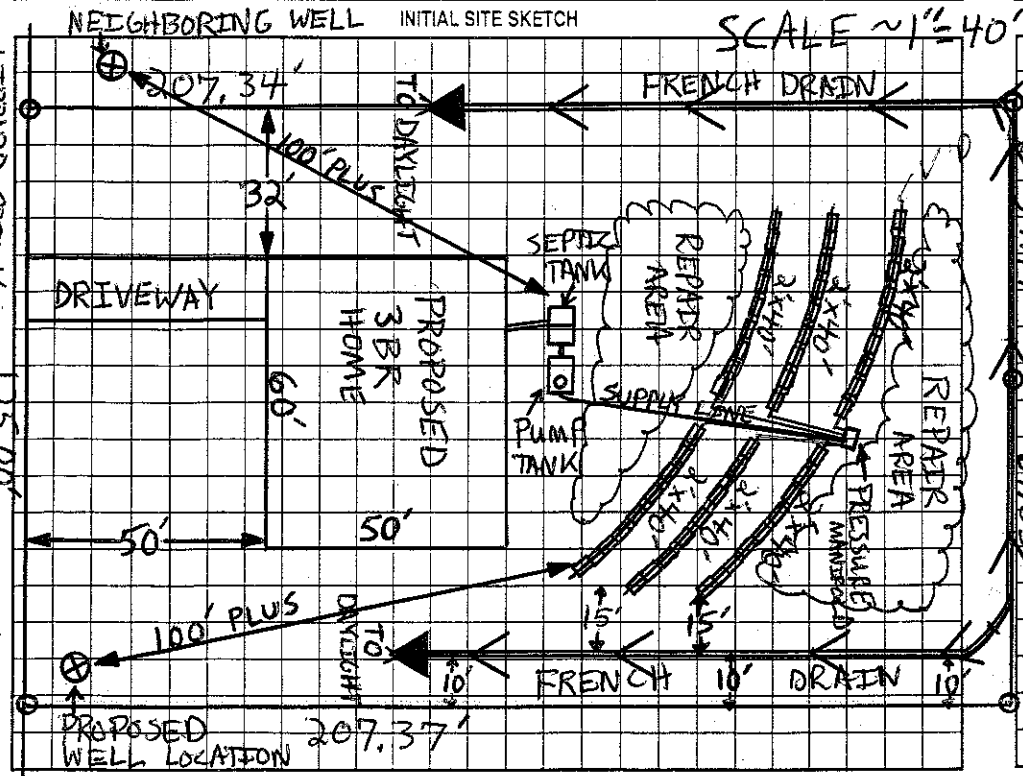

AS BUILT SKETCH

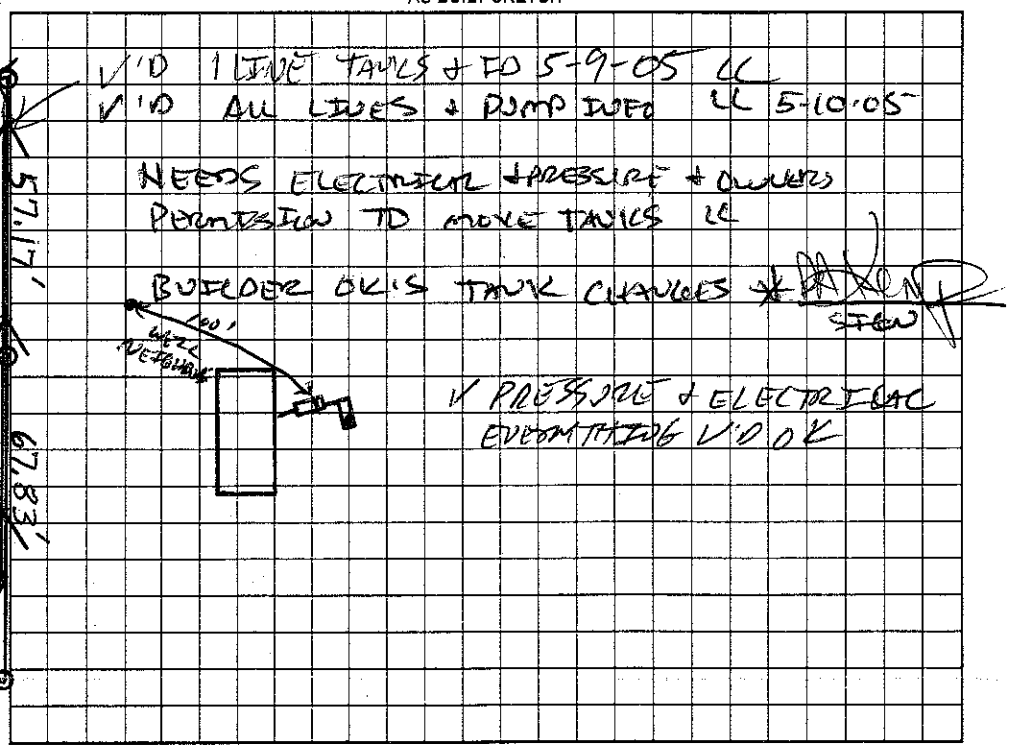

V'D 1 LINE TAPES & FD 5-9-05 CC

V'D ALL LINES & PUMP INFO CC 5-10-05

NEEDS ELECTRICIAN & PRESSURE & OWNERS PERMISSION TO MOVE TANKS CC

BUILDER OK'S TANK CHANGES & [signature] SITE

V PRESSURE & ELECTRICAL EVERYTHING V'D OK

Permit can be suspended or revoked if any false information is supplied toward securing the permit/any unauthorized changes are made to the site/any unauthorized changes are made in the installation of the system. Improvement Permit with plat valid without expiration. Improvement Permit with site plan valid for sixty months. Authorization to Construct is valid for a period equal to that of Improvement Permit – not to exceed sixty months.

Signed Russell Rice date 9/25/02 Installed by: G & M SEPTIC

Improvement Permit by: Patrick Mitchell date 09/09/02 Operation Permit by: [signature] date 9-20-05

Authorization to Construct by: William O. Johnson date 11/19/04 Existing System Inspection by: date

HEALTH DEPT. COPY: WHITE OWNER COPY (FINAL): YELLOW OWNER COPY (INITIAL): PINK