CF

IREDELL COUNTY HEALTH DEPARTMENT

STATESVILLE 704-878-5305 MOORESVILLE 704-664-5281

IMPROVEMENT PERMIT / AUTHORIZATION TO CONSTRUCT / OPERATION PERMIT / EXISTING SYSTEM INSPECTION

PERMIT# IDEAL 135267 PIN# 4722 67 2293 DATE May 17, 2006

OWNER OR APPLICANT Greg Drum / Drum Const. PHONE: Business 704 881-4513 Home

ADDRESS 182 Trailside Rd. Troutman, N.C. 28166

LOCATION From Troutman, Old Mtn Rd. (west) TR Rumple Hill TR Lippard Springs Circle on left

SUBDIVISION Lippard Springs BLOCK / SECTION 7 LOT 153 LOT AREA .6 ac SITE CLASS: PS DESIGN FLOW 360 gpd L.T.A.R. .25

Septic Tank: 1000 Gallons; STB 1087 Date 9-6-06
Pump Tank: Gallons; PT Date
Pump Make: Model Serial No.
Nitrification Field: No Fields Square Feet 1080 Linear Feet 360
No Lines 3 Trench Width 36" Max Trench Bottom Depth 36" Gravel Depth NA

☒ New System ☐ Repair ☐ Expansion System Type: I (II) III IV V VI
System Description: Gravity 25% Red. "Accepted"
Repair System Description: LPPPBPS
Maintenance Agreement Required: ☐ Yes ☒ No

☒ House/Mod. Home No. Bedrooms 3
☐ Mobile Home No. Persons
☐ Business No. Employees
☐ Other


Water Supply: ☒ Individual ☐ Public ☐ Community

☒ Gravity ☐ Pressure ☐ Slab ☒ Crawl Space ☐ Basement w/plumbing ☐ Basement wo/plumbing

Comments:/Conditions:

Comments:/Conditions: BUILDER says syster is 10' off P/L lower CUTBACK; BOWLO Filter Enhancer INSTALLED AS DRAWN NO SOLID PIPE Needed SHALLOW PITCH FILLED + GRADED

1"=50' INITIAL SITE SKETCH

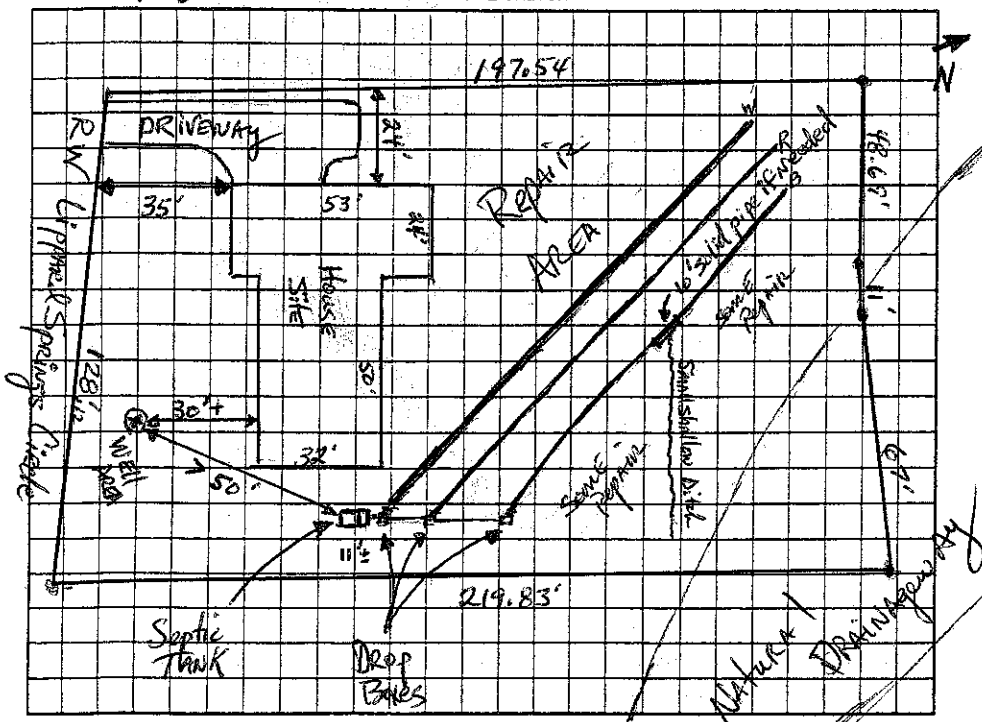

AS BUILT SKETCH

Permit can be suspended or revoked if any false information is supplied toward securing the permit/any unauthorized changes are made to the site/any unauthorized changes are made in the installation of the system. Improvement Permit with plat valid without expiration ☐ Improvement Permit with site plan valid for sixty months ☒ Authorization to Construct is valid for a period equal to that of Improvement Permit – not to exceed sixty months.

Signed: Greg Drum date 5-18-06 Installed by: WAYNE CLONTZ

Improvement Permit by: D. H. Johnson, RS date 5-17-2006 Operation Permit by: D. Cook RS date 10-11-06

Authorization to Construct by: D. H. Johnson, RS date 5-17-2006 Existing System Inspection by: date

HEALTH DEPT. COPY: WHITE OWNER COPY (FINAL): YELLOW OWNER COPY (INITIAL): PINK