IREDELL COUNTY HEALTH DEPARTMENT

STATESVILLE 704-878-5305 MOORESVILLE 704-664-5281

IMPROVEMENT PERMIT / AUTHORIZATION TO CONSTRUCT / OPERATION PERMIT / EXISTING SYSTEM INSPECTION

PERMIT# 107909 PIN# 4722-67-2658 DATE 09/10/02

OWNER OR CONTRACTOR RW RORIE CONSTRUCTION Co PHONE: Business 704-664-4445 Home

ADDRESS 187 DRUM ST. LINCOLNTON, NC 28092

LOCATION OLD MOUNTAIN RD, (L) RUMPLE HILL DR, (R) LIPPARD SPRINGS CR, (L) LIPPARD SPRINGS CR, 5th LOT ON LEFT.

SUBDIVISION LIPPARD SPRINGS BLOCK / SECTION " LOT 115 LOT AREA 0.60 ACRES SITE CLASS. PS DESIGN FLOW 360 GPD L.T.A.R. 0.25

Septic Tank: 1,000 Gallons; STB 1012 Date 09/22/02
Pump Tank: 1,000 Gallons; PT 17 Date 01/05/03
Pump Make: GOULDS Model WE0712 Serial No. C0362774 (3/4 HP)
Nitrification Field: No Fields 1 Square Feet EQ to 1,440 Linear Feet 360
No Lines 5x72' Trench Width 36" Max Trench Bottom Depth 36"

[X] New System [ ] Repair System Type: I, II, (III) IV, V, VI
System Description: PUMP, 25% REDUCTION
Repair System Description: LOW PRESSURE 50% REDUCTION
Maintenance Agreement Required: [ ] Yes [X] No

[X] House/Mod. Home No. Bedrooms 3
[ ] Mobile Home No. Bathrooms 2
[ ] Business No. Employees
[ ] Other
[ ] Slab [ ] Crawl Space [ ] Basement w/plumbing [ ] Basement wo/plumbing


Water Supply: [X] Individual [ ] Public [ ] Community WELL

Comments/Conditions: (1) MAINTAIN ALL SETBACKS, 100 FEET FROM ANY WELL, 25' UPSLOPE FROM NEIGHBORING FRENCH DRAIN (2) CALL PRIOR TO INSTALLATION IF REFLAGGING IS NEEDED AND FOR PUMP AND PRESSURE MANIFOLD INFO.


Comments/Conditions:

- S.T. INSTALLED USING TUFF-TIGHT FILTER.

INITIAL SITE SKETCH

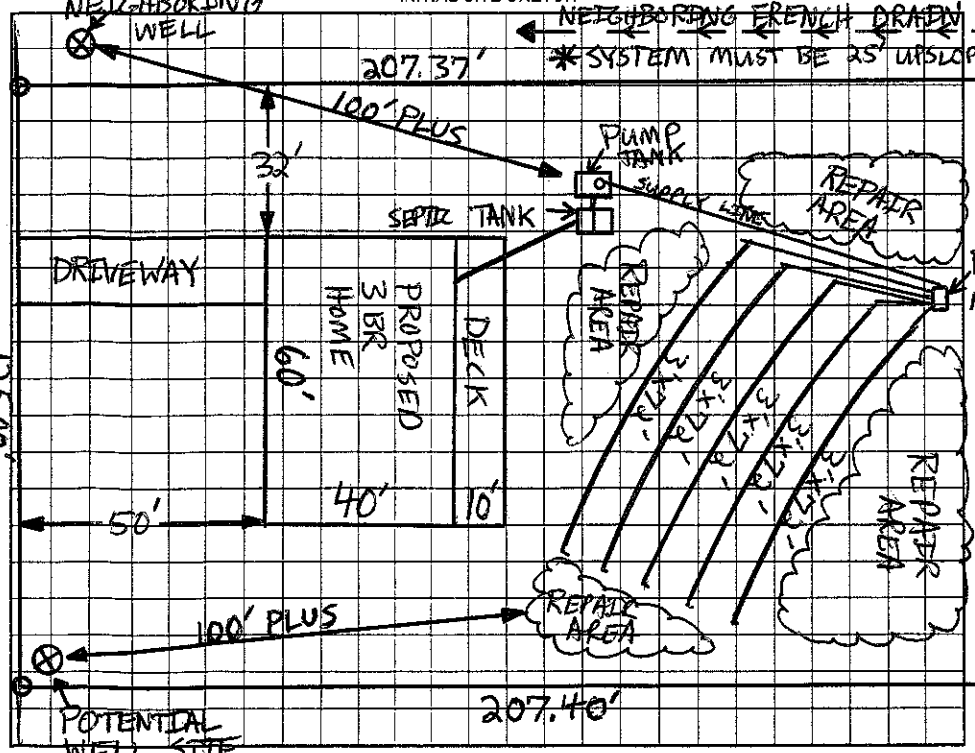

AS BUILT SKETCH

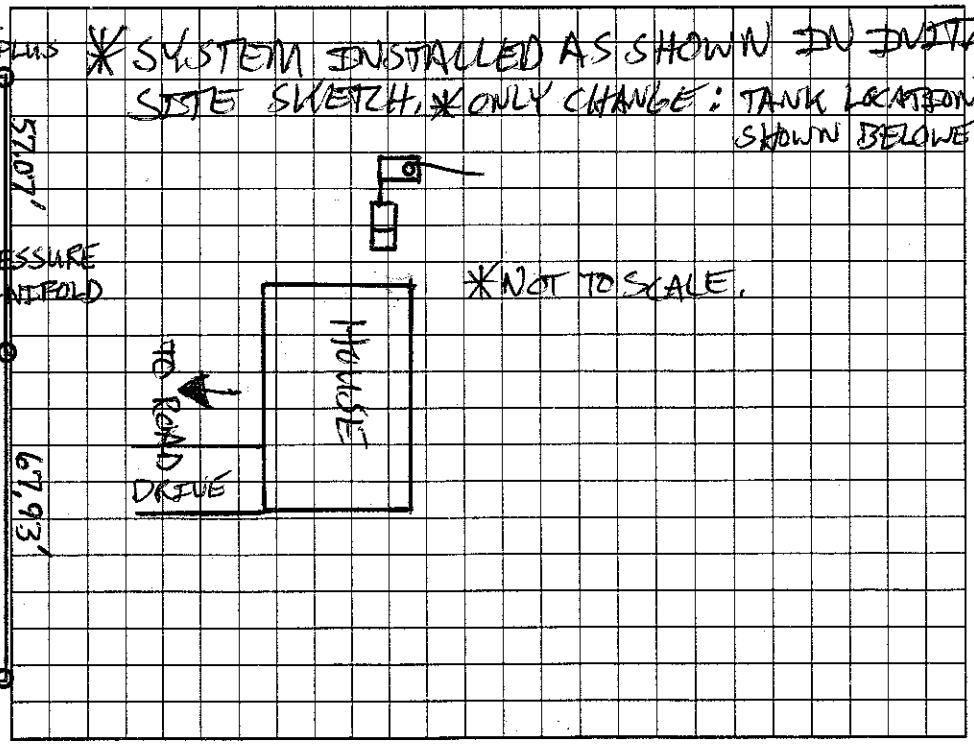

Permit can be suspended or revoked if any false information is supplied toward securing the permit/any unauthorized changes are made to the site/any unauthorized changes are made in the installation of the system. Improvement Permit with plat valid without expiration. Improvement Permit with site plan valid for sixty months. Authorization to Construct is valid for a period equal to that of Improvement Permit – not to exceed sixty months.

Signed Russell Rini date 9/25/02 Installed by: TOMMY KRYE 5-13-03

Improvement Permit by: Patrick Mitchell date 09/10/02 Operation Permit by: Patrick Mitchell date 06/24/03

Authorization to Construct by: Patrick Mitchell date 12/18/02 Existing System Inspection by: date

HEALTH DEPT. COPY: WHITE OWNER COPY (FINAL): YELLOW OWNER COPY (INITIAL): PINK