IREDELL COUNTY HEALTH DEPARTMENT

CI

STATESVILLE 704-878-5305 MOORESVILLE 704-664-5281

IMPROVEMENT PERMIT / AUTHORIZATION TO CONSTRUCT / OPERATION PERMIT / EXISTING SYSTEM INSPECTION

PERMIT# 108903 PIN# 4722 67 3687 DATE 7/26/05

OWNER OR CONTRACTOR R W ROPER CONSTRUCTION LLC PHONE: Business 658-0881 Home

ADDRESS 105 DENVER BUS. PK. DR. UNIT G. MOORESVILLE NC 28115

LOCATION OMC - TL RUMPLE HILL - TL LIPPARD SPRINGS CIRCLE - GO LEFT - ON LT

SUBDIVISION LIPPARD SPRINGS BLOCK / SECTION VII LOT 116 LOT AREA 1.64C SITE CLASS PS DESIGN FLOW 360GPD L.T.A.R. .36PD/LOT

Septic Tank: 1000 Gallons; STB 1007 Date 04/14/06
Pump Tank: 1000 Gallons; PT 1007 Date 04/04/06
Pump Make: LITTLE GIANT Model 9QHH LITTLE GIANT Serial No. 4/10 HP
Nitrification Field: No Fields 1 Square Feet 900 Linear Feet 300
No Lines 3@100' Trench Width 36" Max Trench Bottom Depth 36" Gravel Depth N/A

☒ New System ☐ Repair System Type: I, II, III, IV, V, VI
System Description: PUMP 25% REDUCTION
Repair System Description: PUMP PANEL
Maintenance Agreement Required: ☐ Yes ☒ No


☒ House/Mod. Home No. Bedrooms 3
☐ Mobile Home No. Bathrooms 3
☐ Business No. Employees
☐ Other
☐ Slab ☒ Crawl Space ☐ Basement w/plumbing ☐ Basement wo/plumbing

Water Supply: ☒ Individual ☐ Public ☐ Community


Comments:/Conditions: 1) DO NOT CUT FOR HOUSE
Approved 3 BEDROOM PLAN ON 11-18-05
KEEP HOUSE OUT OF GROUND & BACKFILL FOR

Comments:/Conditions: POSITIVE DRAINAGE REQMTS.
NO DRAIN CAN BE INSTALLED.
(POWCAN FILTER (NSF) BROWN)

INITIAL SITE SKETCH 1"=50'

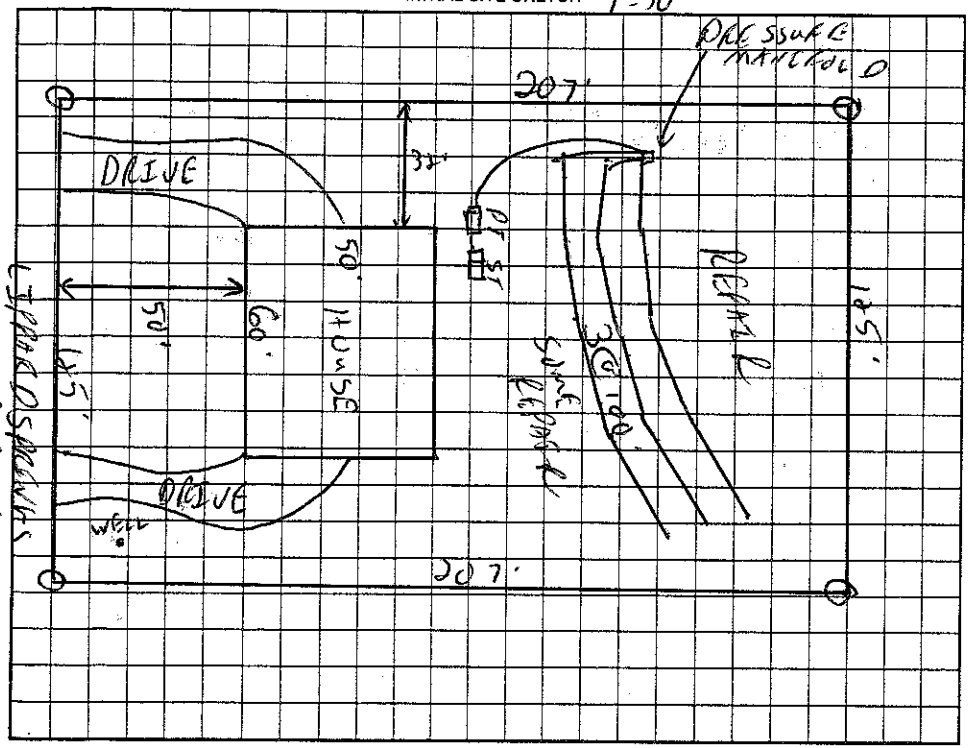

AS BUILT SKETCH

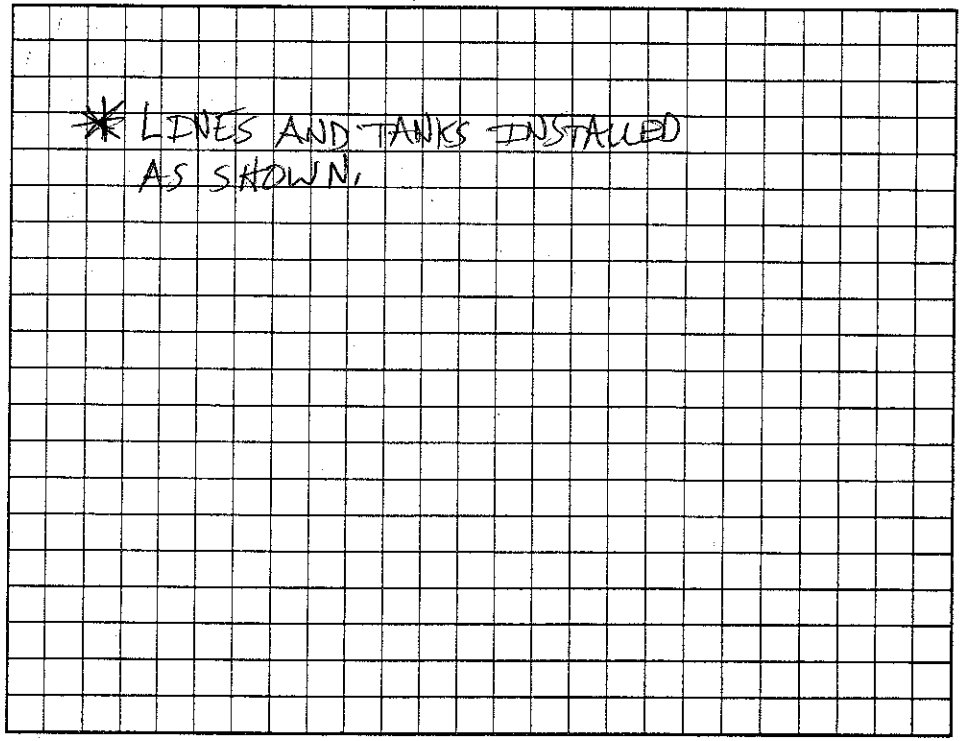

Permit can be suspended or revoked if any false information is supplied toward securing the permit/any unauthorized changes are made to the site/any unauthorized changes are made in the installation of the system. Improvement Permit with plat valid without expiration. Improvement Permit with site plan valid for sixty months. Authorization to Construct is valid for a period equal to that of Improvement Permit – not to exceed sixty months.

Signed: [signature] date 8-11-03 Installed by: RICHARD ABERNATHY (05/24/06)

Improvement Permit by: [signature] KS date 7/26/05 Operation Permit by: [signature] PS date 6-2-06

Authorization to Construct by: [signature] date 11-18-05 Existing System Inspection by: date

HEALTH DEPT. COPY: WHITE OWNER COPY (FINAL): YELLOW OWNER COPY (INITIAL): PINK