IREDELL COUNTY HEALTH DEPARTMENT

STATESVILLE 704-878-5305 MOORESVILLE 704-664-5281

CI

IMPROVEMENT PERMIT / AUTHORIZATION TO CONSTRUCT / OPERATION PERMIT / EXISTING SYSTEM INSPECTION

PERMIT# 108974 PIN# 4722-67-~~5702~~ 4116.4 DATE 1/23/08

OWNER OR APPLICANT Cool Springs Builders PHONE: Business 704-402-9799 Home 704-883-0839

ADDRESS P.O. BOX 2040 Statesville NC 28687

LOCATION OMR ① Rumple Hill ② Lippard Springs on LEFT LOT # 15th

SUBDIVISION Lippard Springs BLOCK / SECTION ____ LOT 15th LOT AREA 1.34 SITE CLASS. PS DESIGN FLOW 360 L.T.A.R. .3

Septic Tank: 1000 Gallons: STB 1002 Date 6-4-07

Pump Tank: 1000 Gallons: PT 17 Date 3-27-07

Pump Make: Goulds Model WE0 3111m Serial No. ____

Nitrification Field: No Fields 1 Square Feet 60=1200' Linear Feet 300'

No Lines 3x100' Trench Width 36" Max Trench Bottom Depth 36" Gravel Depth N/A ☐ Gravity ☒ Pressure

☒ New System ☐ Repair ☐ Expansion System Type: I II III IV V VI

System Description: Pump 250/4 Pedalt

Repair System Description: LP 50'/4 Pedalt

Maintenance Agreement Required: ☐ Yes ☒ No

☒ House/Mod. Home ☐ Mobile Home ☐ Business ☐ Other

No. Bedrooms 3 No. Persons 6 No. Employees ____

Water Supply: ☒ Individual ☐ Public ☐ Community

☐ Slab ☐ Crawl Space ☒ Basement w/plumbing ☐ Basement wo/plumbing

Comments/Conditions: ① House Built & Well Drilled at time of Redraw ② Maintain Setbacks ③ This Permit Replaces Previously Issued Permit Dated 7/23/03.

Comments/Conditions: Tuffline Filter & Risers Tanks set where risers 6" under natural soils. F.U to be removed, system 10'± off marked p/l. Tanks 63' from well

INITIAL SITE SKETCH

SEE ATTACHED SYSTEM DESIGN BY LORNE COOK, P.S.

AS BUILT SKETCH

Permit can be suspended or revoked if any false information is supplied toward securing the permit/any unauthorized changes are made to the site/any unauthorized changes are made in the installation of the system. Improvement Permit with plat valid without expiration ☐ Improvement Permit with site plan valid for sixty months ☒ Authorization to Construct is valid for a period equal to that of Improvement Permit – not to exceed sixty months.

Signed: Cool Spring Builders, Inc. date 1-23-08

Improvement Permit by: date 1/23/08


Authorization to Construct by: date 1/23/08

Installed by: (Craig Thompson) Grading & Septic

Operation Permit by: date 3-26-08

Existing System Inspection by: date ____

HEALTH DEPT. COPY: WHITE OWNER COPY (FINAL): YELLOW OWNER COPY (INITIAL): PINK

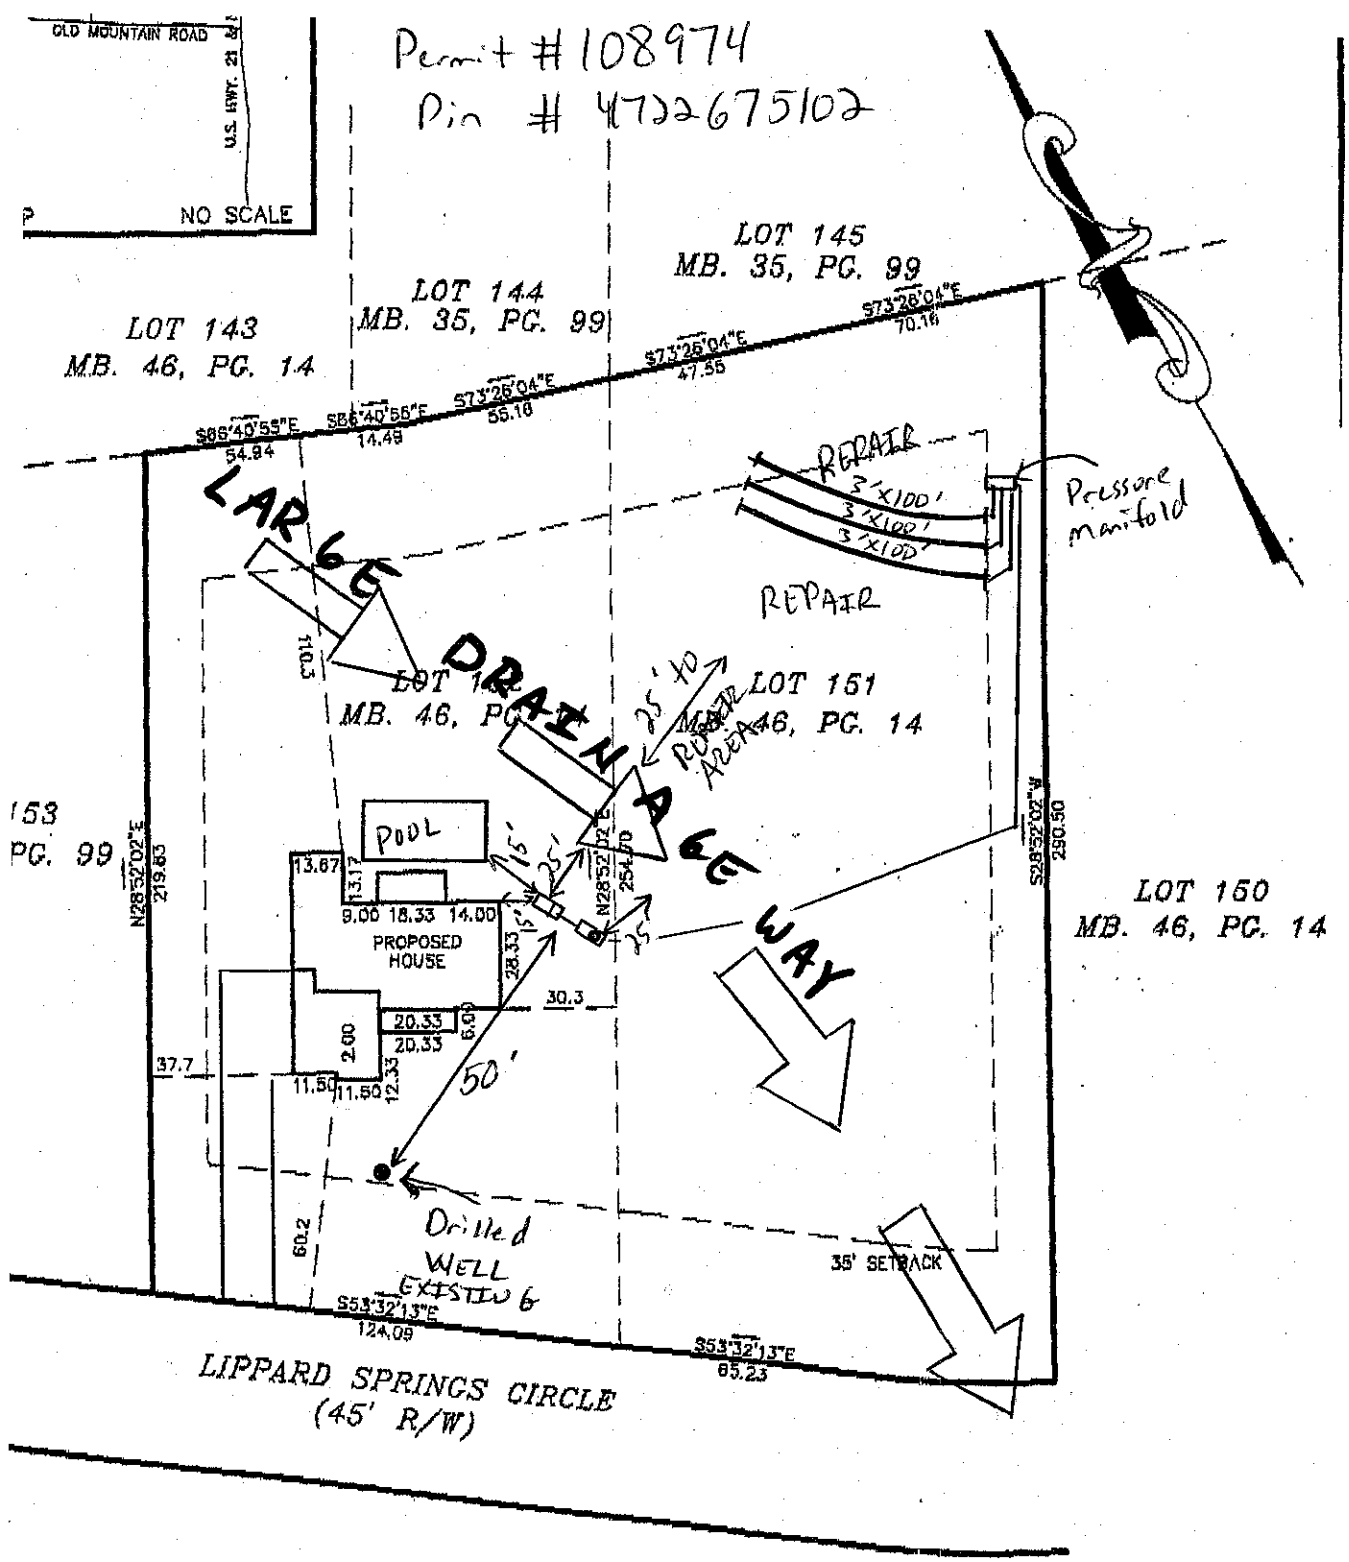

LEGEND

s = P.P. = POWER POLE
= DUKE POWER TRANS.
= EXISTING IRON FOUND
= #4 REBAR SET
= RIGHT-OF-WAY

E -

RED BY:

PLOT PLAN SURVEY

OF

LOT 151 & 152 LIPPARD SPRINGS

STATESVILLE OUTSIDE TWSP., NC

COOL SPRING BUILDERS, INC.

NOTES

1) THIS PROPERTY MAY BE SUBJECT TO ANY EASEMENTS AND/OR RIGHTS OF WAY OF RECORD.
2) ACREAGE COMPUTED BY THE COORDINATE METHOD.
3) UNDERGROUND POWER
4) NO GRID MONUMENT FOUND WITHIN 2000 FEET.

FIELD BOOK:
FILE: LIPPARD SPRINGS
DC FILE:
TAX MAP NO: 4722674184