IREDELL COUNTY HEALTH DEPARTMENT

STATESVILLE 704-878-5305 MOORESVILLE 704-664-5281

IMPROVEMENT PERMIT / AUTHORIZATION TO CONSTRUCT / OPERATION PERMIT / EXISTING SYSTEM INSPECTION

PERMIT# 32499 PIN# 4722675607 DATE 6-2-06

OWNER OR APPLICANT Timothy Perry PHONE: Business 704-500-3600 Home

ADDRESS 160 SHEPHERD RD MOORESVILLE NC 28115

LOCATION 40 WEST ON CR 1 RIGHT HILL ON LEFT APPROX 6/10 MI ON RT WITH 117

SUBDIVISION Lippard Spring BLOCK / SECTION VII LOT 117 LOT AREA .595 AC SITE CLASS. PS DESIGN FLOW 360 L.T.A.R. .3

Septic Tank: 1000 Gallons; STB 1507 Date 5-2-04
Pump Tank: 1000 Gallons; PT 274 Date 4-13-06
Pump Make: _____ Model LG90H-ETL-PC Serial No. 05M095878
Nitrification Field: No Fields 1 Square Feet EB=1200' Linear Feet 300'
No Lines 3x100' Trench Width 36" Max Trench Bottom Depth 36" Gravel Depth N/A ☐ Gravity ☒ Pressure

☒ New System ☐ Repair ☐ Expansion System Type: I (II) III IV V VI
System Description: Pump to 3x40 Pressure
Repair System Description: LD 3x40 Pressure
Maintenance Agreement Required: ☐ Yes ☒ No

☒ House/Mod. Home No. Bedrooms 3
☐ Mobile Home No. Persons 6
☐ Business No. Employees ____
☐ Other ____


Water Supply: ☒ Individual ☐ Public ☐ Community

☐ Slab ☒ Crawl Space ☐ Basement w/plumbing ☐ Basement wo/plumbing


Comments:/Conditions: (1) INSTALL LINES ON CONTOURS (2) MAINTAIN SETBACKS (3) DONUT OUT THE POSITIVE DRAINAGE REQUIRED. FILL SIDESLOPE IS 15' NO FOUNDATION DRAIN IS ALLOWED.

Comments:/Conditions:
Pump - filter Orange

INITIAL SITE SKETCH 1" = 40'

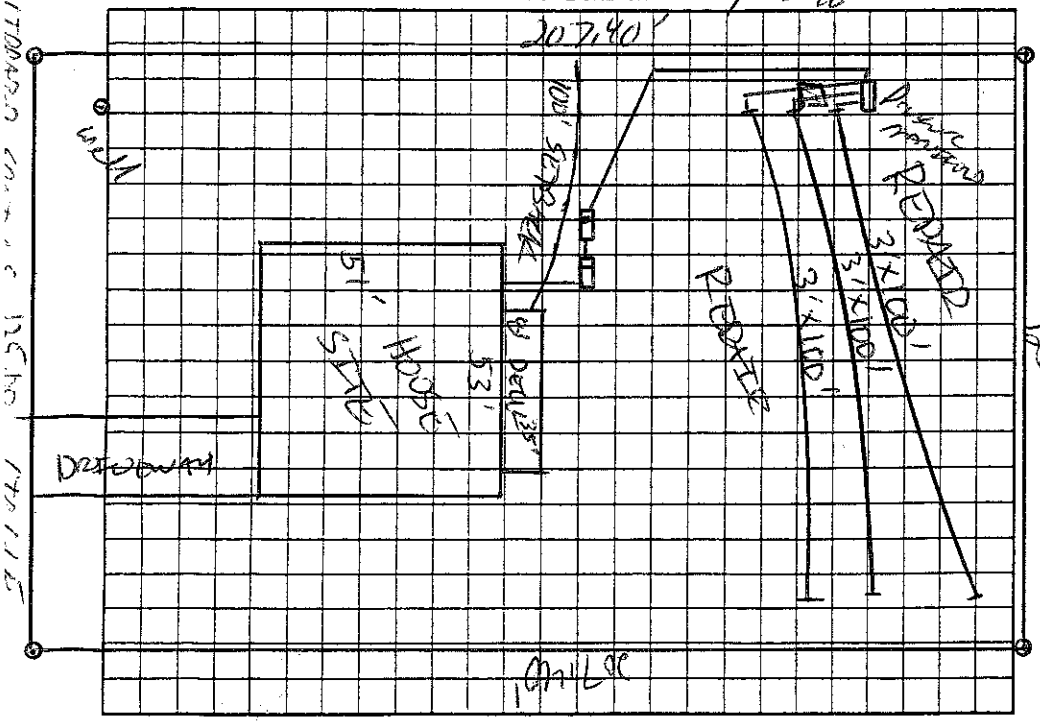

AS BUILT SKETCH

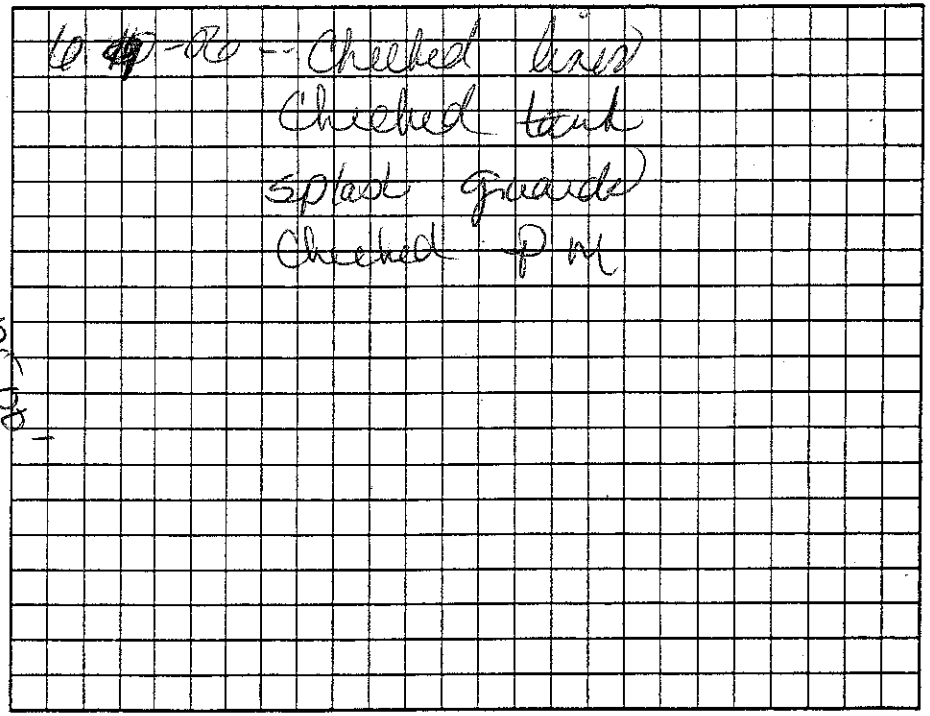

Permit can be suspended or revoked if any false information is supplied toward securing the permit/any unauthorized changes are made to the site/any unauthorized changes are made in the installation of the system. Improvement Permit with plat valid without expiration ☐ Improvement Permit with site plan valid for sixty months ☒ Authorization to Construct is valid for a period equal to that of Improvement Permit – not to exceed sixty months.

Signed: _____ date 6-9-06 Installed by: Abernathy

Improvement Permit by: _____ date 6-5-06 Operation Permit by: _____ date 8-7-06

Authorization to Construct by: _____ date 6-5-06 Existing System Inspection by: _____ date _____

HEALTH DEPT. COPY: WHITE OWNER COPY (FINAL): YELLOW OWNER COPY (INITIAL): PINK