IREDELL COUNTY HEALTH DEPARTMENT

STATESVILLE 704-878-5305 MOORESVILLE 704-664-5281 58776

IMPROVEMENT PERMIT / CERTIFICATE OF COMPLETION / OPERATION PERMIT / EXISTING SYSTEM INSPECTION

PROPERTY DESCRIPTION NO. 22806 DATE 12-7-95 TAX MAP NO. 6C6-A-60

OWNER OR CONTRACTOR Heritage Bldg Co. PHONE: Business ______ Home 528-6644 Watershed: ☐ Yes ☒ No

ADDRESS 120 Hickory Pt. Ct. Sta

LOCATION old mtn Rd TR Rumple Dr. TR Stonefield Dr on rt before end

SUBDIVISION Lippard Sp. BLOCK / SECTION ______ LOT 60 LOT AREA 125X225 SITE CLASS. PS DESIGN FLOW 360 L.T.A.R. .3

Septic Tank: 1000 Gallons; STB 1012 Date 5-11-96

Pump Tank: ______ Gallons; PT ______ Date ______

Pump Make: ______ Model ______ Serial No. ______

Nitrification Field: No Fields 1 Square Feet 1200 Linear Feet 400

No Lines 4 Trench Width 36" Max Trench Bottom Depth 36" Gravel Depth 12"

☒ New System ☐ Repair System Type: I, II, III, IV, V, VI (II circled)

System Description: Conv. Gravity

Repair System Description: Graveless chambers

Maintenance Agreement Required: ☐ Yes ☒ No

☐ Slab ☒ Crawl Space ☐ Basement w/plumbing ☐ Basement wo/plumbing

☒ House/Mod. Home ☐ Mobile Home ☐ Business ☐ Other ______


No. Bedrooms 3 No. Bathrooms 2 No. Employees ______

Water Supply: ☒ Individual ☐ Community ☐ Public

Comments:

Comments:

INITIAL SITE SKETCH

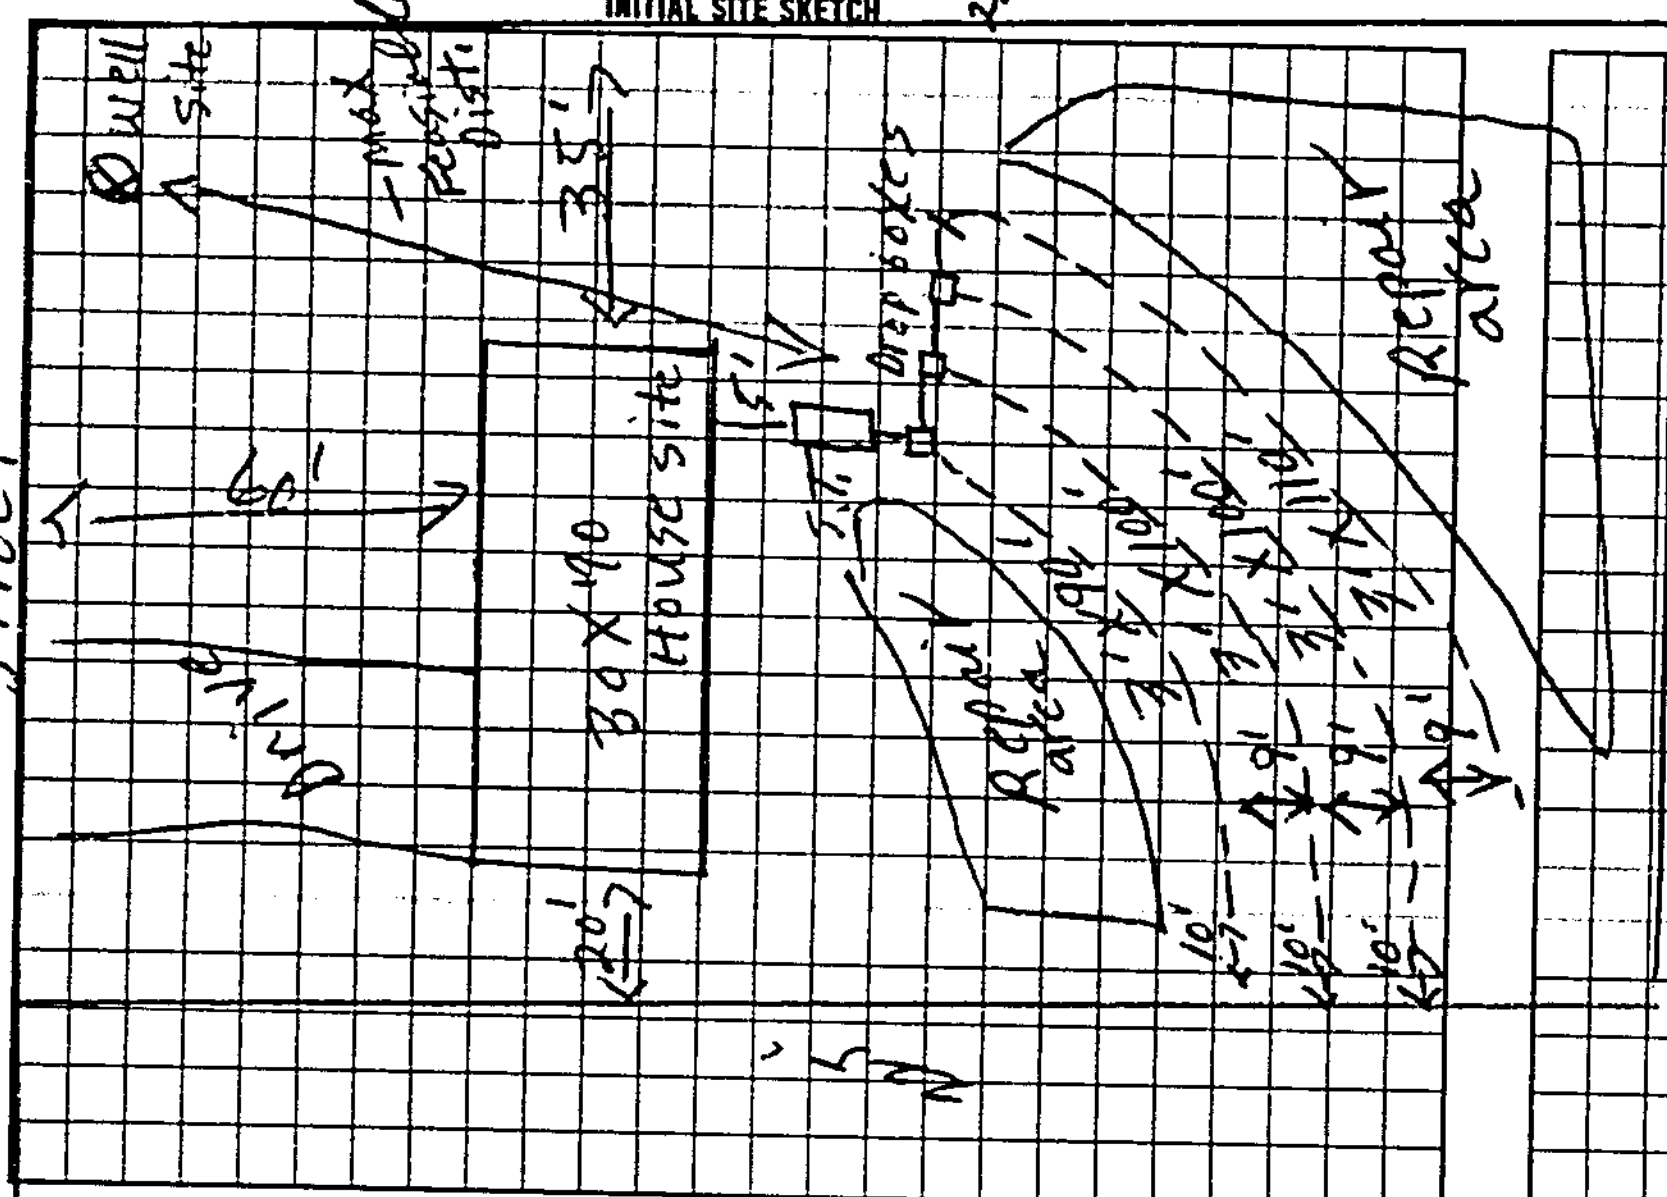

AS BUILT SKETCH

Same as initial sketch

I understand that this permit can be suspended or revoked if any false information is supplied toward securing the permit/any unauthorized changes are made to the site/any unauthorized changes are made in the installation of the system.

Signed: [signature]

Improvement Permit by: L. C. Moore date 12-7-95

Authorization Existing System Inspection by: L. C. Moore date 12-7-95

Installed by: Tommy Frye

Certificate of Completion by: ______ date ______

Operation Permit by: L. C. Moore date 8-5-96

to const. HEALTH DEPT. COPY WHITE INSPECTION COPY (FINAL) GREEN OWNER COPY (FINAL) YELLOW INSPECTION COPY (INITIAL) PINK OWNER COPY (INITIAL) GOLD

Authorization to const. Expires 60 mos from issue date

22000