IREDELL COUNTY HEALTH DEPARTMENT

STATESVILLE 704-878-5305 MOORESVILLE 704-664-5281

IMPROVEMENT PERMIT / AUTHORIZATION TO CONSTRUCT / OPERATION PERMIT / EXISTING SYSTEM INSPECTION

PERMIT# 093920 PIN# 4722676637 / LOT 18 DATE 02-06-01

OWNER OR CONTRACTOR HERITAGE BLDG CO PHONE: Business 528-6694 Home

ADDRESS 120 HICKORY PT CR

LOCATION NE OMR, ® RUMPLE HILL, ® LEPPARD SPRINGS

SUBDIVISION LEPPARD SPRINGS BLOCK / SECTION LOT 118 LOT AREA .6 ACRE SITE CLASS PS DESIGN FLOW 360 L.T.A.R. .3 GPD/FT²

Septic Tank: 1000 Gallons: STB 1012 Date 2-26-01
Pump Tank: Gallons: PT Date
Pump Make: Model Serial No
Nitrification Field: No Fields Square Feet 1200 Linear Feet 400
No Lines 4 Trench Width 36" Max Trench Bottom Depth 36" Gravel Depth

☒ New System ☐ Repair System Type: I (II) III IV V VI
System Description: CONV GRAVITY
Repair System Description: PUMP 50% REDUCTION
Maintenance Agreement Required: ☐ Yes ☒ No


☒ House/Mod. Home No. Bedrooms 3
☐ Mobile Home No. Bathrooms 2
☐ Business No. Employees
☐ Other
☐ Slab ☒ Crawl Space ☐ Basement w/plumbing ☐ Basement wo/plumbing

Water Supply: ☒ Individual ☐ Public ☐ Community WELL


Comments/Conditions: ① INSTALL LINES ON CONTOUR ② USE 4 DROP BOXES ③ KEEP WELL 100' AWAY FROM SYSTEM ④ KEEP SYSTEM 10' off property lines + 5' off home

Comments/Conditions: INSTALLED AS BELOW WITH POLYLOK FILTER & MARKER

INITIAL SITE SKETCH 1"=50'

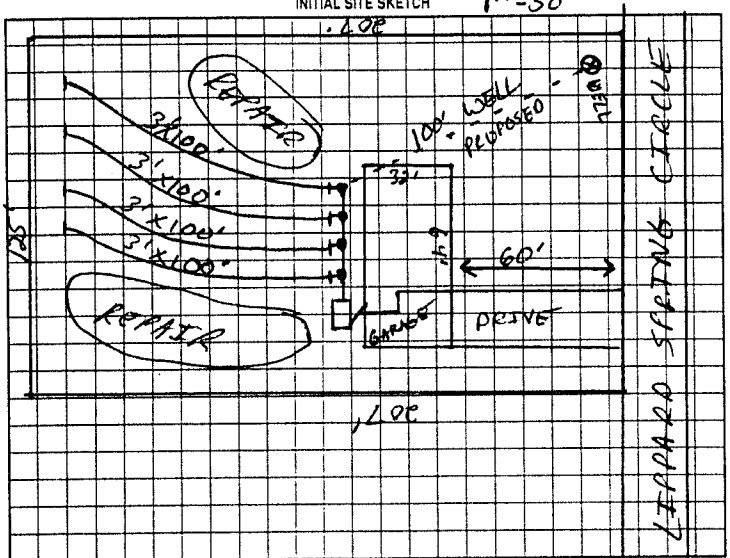

AS BUILT SKETCH

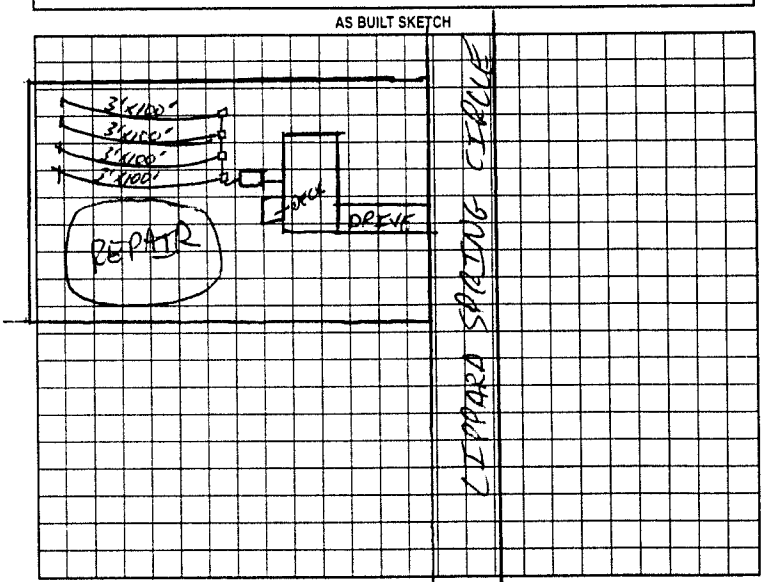

Permit can be suspended or revoked if any false information is supplied toward securing the permit/any unauthorized changes are made to the site/any unauthorized changes are made in the installation of the system. Improvement Permit with plat valid without expiration. Improvement Permit with site plan valid for sixty months. Authorization to Construct is valid for a period equal to that of Improvement Permit – not to exceed sixty months.

Signed: date 2-6-01

Improvement Permit by: RSI date 2-6-01

Authorization to Construct by: RSI date 2-6-01

Installed by: date

Operation Permit by: RSI date 4-27-01

Existing System Inspection by: date

HEALTH DEPT. COPY: WHITE OWNER COPY (FINAL): YELLOW OWNER COPY (INITIAL): PINK