IREDELL COUNTY HEALTH DEPARTMENT

STATESVILLE 704-878-5305 MOORESVILLE 704-664-5281

IMPROVEMENT PERMIT / AUTHORIZATION TO CONSTRUCT / OPERATION PERMIT / EXISTING SYSTEM INSPECTION

PERMIT# 100145 PIN# 4722267 7381 DATE 5/17/01

OWNER OR CONTRACTOR Heritage Bldg Co. PHONE: ~~Business~~ 902-0880 Home (704) 528-6644

ADDRESS 120 Hickory Pt CR Statesville NC 28677

LOCATION I-40 W, (L) on Mtn Rd, (L) Rumple Hill Dr (R) Lippard Springs Circle on Left

SUBDIVISION Lippard Springs BLOCK / SECTION — LOT 147 LOT AREA .6 SITE CLASS ~~V~~ DESIGN FLOW 360 L.T.A.R. .25

Septic Tank: 4,000 Gallons: STB 1012 Date 03/22/02
Pump Tank: ____ Gallons; PT ____ Date ____
Pump Make: ____ Model equivalent to Serial No. ____
Nitrification Field: No Fields 1 Square Feet 1440 Linear Feet ~~360~~ ~~400~~
No Lines 4 @ 90' Trench Width 36" Max Trench Bottom Depth — Gravel Depth —

[X] New System [ ] Repair System Type: I, II, (III) IV, V, VI
System Description: Gravity, 25% Reduction
Repair System Description: Pump, 50% Reduction
Maintenance Agreement Required: [ ] Yes [X] No
[ ] Slab [X] Crawl Space [ ] Basement w/plumbing [ ] Basement wo/plumbing


[X] House/Mod. Home [ ] Mobile Home [ ] Business [ ] Other
No. Bedrooms 3 No. Bathrooms 2 No. Employees ____

Water Supply: [X] Individual [ ] Public [ ] Community

Comments/Conditions: ① Use 25% Reduction System either HDPE Sections or Chambers ② Keep 100' from well

Comments/Conditions: - SEPTIC TANK INSTALLED USING POLYLOCK FILTER & SEPTIC MARKER

INITIAL SITE SKETCH

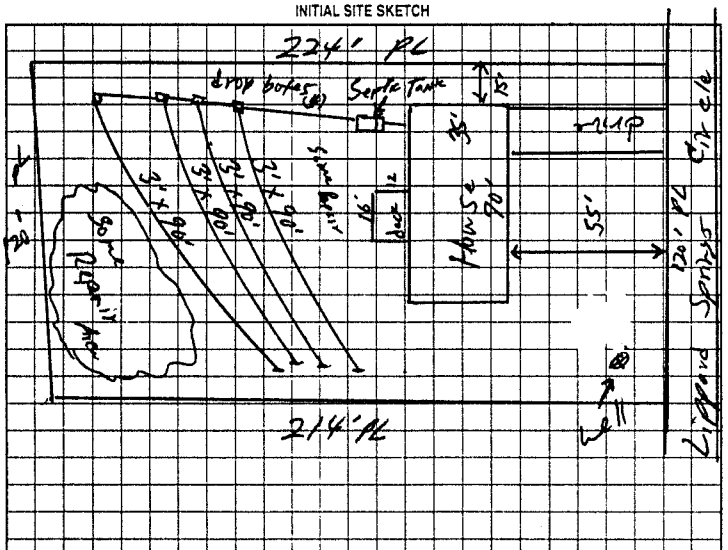

AS BUILT SKETCH

SYSTEM INSTALLED AS SHOWN IN INITIAL SITE SKETCH

Permit can be suspended or revoked if any false information is supplied toward securing the permit/any unauthorized changes are made to the site/any unauthorized changes are made in the installation of the system. Improvement Permit with plat valid without expiration. Improvement Permit with site plan valid for sixty months. Authorization to Construct is valid for a period equal to that of Improvement Permit – not to exceed sixty months.

Signed: Sarah Dyer date 6-5-01 Installed by: FRYE GRADING & SEPTIC

Improvement Permit by: William E. Johnson RSI date 5/17/01 Operation Permit by: Patricia Mitchell date 08/09/02

Authorization to Construct by: William E. Johnson RSI date 5/17/01 Existing System Inspection by: ____ date ____

HEALTH DEPT. COPY: WHITE OWNER COPY (FINAL) YELLOW OWNER COPY (INITIAL) PINK