IREDELL COUNTY HEALTH DEPARTMENT

PT OF 63171

STATESVILLE 704-878-5305 MOORESVILLE 704-664-5281

IMPROVEMENT PERMIT / CERTIFICATE OF COMPLETION / OPERATION PERMIT / EXISTING SYSTEM INSPECTION

PROPERTY DESCRIPTION NO. 17535 DATE 5/26/94 TAX MAP NO. 10D A-20 (50) Watershed: ☐ Yes ☒ No

OWNER OR CONTRACTOR HERITAGE BLDG. Co. PHONE: Business 871-7135 Home 528-6644

ADDRESS RT. 10, Box 177-A, STATESVILLE, NC 28677

LOCATION NC 115 N, TR S. CHIPLEY FORD RD, TL J.P'S LANE, AT END ON (R)

SUBDIVISION MEADOW OAKS BLOCK / SECTION ____ LOT 50 LOT AREA ~150'x370' SITE CLASS. PS DESIGN FLOW 360 L.T.A.R. 0.35 GPD/FT2

Septic Tank: 1000 Gallons: STB 10-15-96 Date 10/2

Pump Tank: ____ Gallons: PT ____ Date ____

Pump Make: ____ Model ____ Serial No. ____

Nitrification Field: No Fields 1 Square Feet 1035 Linear Feet 345

No Lines 3 Trench Width 36" Max Trench Bottom Depth 18-36" Gravel Depth 12"

☒ New System ☐ Repair System Type: I II III IV V VI

System Description: CONVENTIONAL GRAVITY

Repair System Description: CONV. GRAVITY

Maintenance Agreement Required: ☐ Yes ☒ No

☒ House/Mod. Home No. Bedrooms 3

☐ Mobile Home No. Bathrooms 2

☐ Business No. Employees ____

☐ Other ____


☐ Slab ☒ Crawl Space ☐ Basement w/plumbing ☐ Basement wo/plumbing

Water Supply: ☐ Individual ☐ Community ☒ Public


Comments:

Comments: SYSTEM CHANGED DUE TO STMS-OUT LOCATION W/O PRIOR H.D. APPROVAL; INSTALLED AS SHOWN BELOW

INITIAL SITE SKETCH

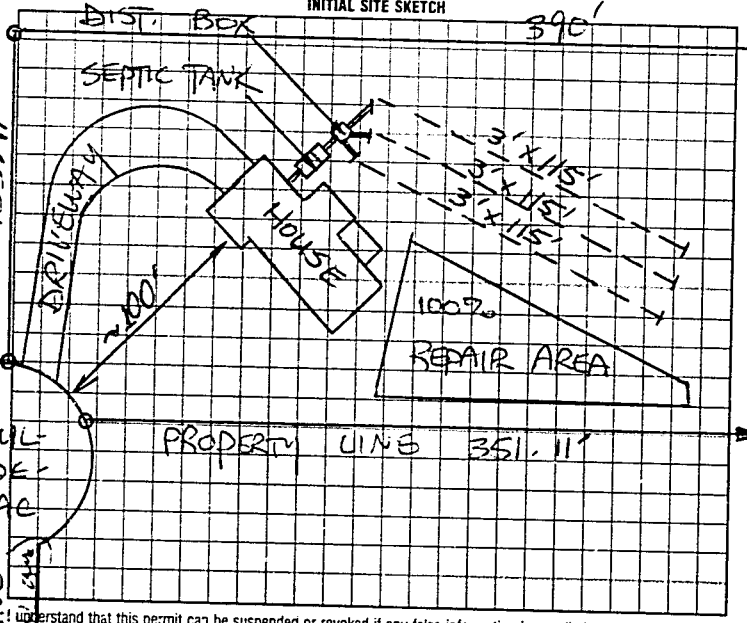

AS BUILT SKETCH

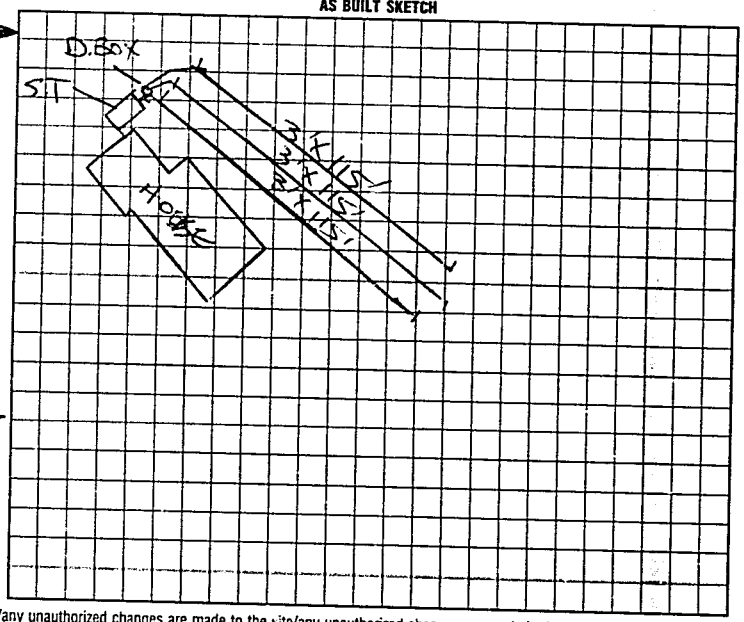

I understand that this permit can be suspended or revoked if any false information is supplied toward securing the permit/any unauthorized changes are made to the site/any unauthorized changes are made in the installation of the system. Improvement Permit is valid for 60 months from date of issuance.

Signed: ____

Improvement Permit by: STEVE HEDRICK date 5/26/94

Existing System Inspection by: ____ date ____

Installed by: TOMMY FRYE

Certificate of Completion by: ____ date ____

Operation Permit by: STEVE HEDRICK date 1-21-97

HEALTH DEPT COPY: WHITE INSPECTION COPY (FINAL): GREEN OWNER COPY (FINAL): YELLOW INSPECTION COPY (INITIAL): PINK OWNER COPY (INITIAL): GOLD