IREDELL COUNTY HEALTH DEPARTMENT

STATESVILLE 704-878-5305 MOORESVILLE 704-664-5281

IMPROVEMENT PERMIT / AUTHORIZATION TO CONSTRUCT / OPERATION PERMIT / EXISTING SYSTEM INSPECTION

PERMIT# 07345 PIN# 4772672705 DATE 3/20/98

OWNER OR CONTRACTOR Rick Dyson / Heritage Builders PHONE: Business (704) 523-6644 Home

ADDRESS 120 Hickory Place Ct. Statesville, NC 28677

LOCATION Old Mountain Rd TR Rumple Hill Dr. 30 past St. Joseph Ct. on right.

SUBDIVISION Lippard Spgs BLOCK / SECTION 4 LOT 99 LOT AREA .70 Acre SITE CLASS. PS DESIGN FLOW 360 L.T.A.R. .3

Septic Tank: 1000 Gallons; STB 1012 Date 3-6-98
Pump Tank: Gallons; PT Date
Pump Make: Model Serial No.
Nitrification Field: No Fields 1 Square Feet 1200 Linear Feet 400
No Lines 5 at 80' Trench Width 36" Max Trench Bottom Depth 22"-33" Gravel Depth 12"

[X] New System [ ] Repair System Type: [ ] I [X] II [ ] III [ ] IV [ ] V [ ] VI
System Description: Grav. - Conventional
Repair System Description: Same
Maintenance Agreement Required: [ ] Yes [X] No
[ ] Slab [X] Crawl Space [ ] Basement w/plumbing [ ] Basement wo/plumbing


[X] House/Mod. Home No. Bedrooms 3
[ ] Mobile Home No. Bathrooms 3
[ ] Business No. Employees
[ ] Other

Water Supply: [X] Individual [ ] Public [ ] Community


Comments:/Conditions: Keep Septic System at least 5' from House & 10' From Property lines.

Comments:/Conditions:

INITIAL SITE SKETCH Scale 1:50

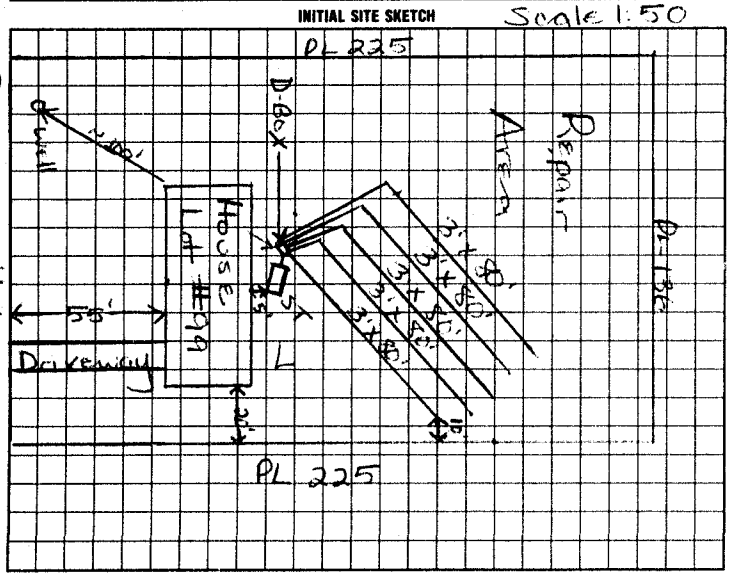

AS BUILT SKETCH

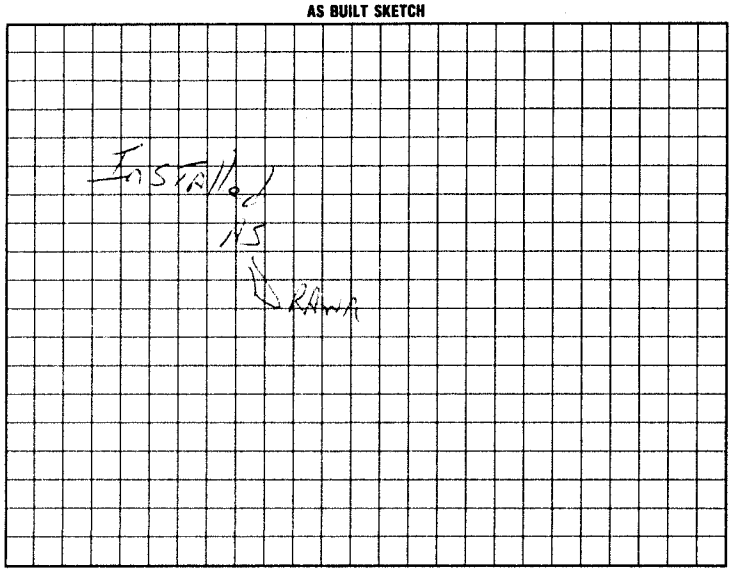

Rumple Hill Dr.

I understand that this permit can be suspended or revoked if any false information is supplied toward securing the permit/any unauthorized changes are made to the site/any unauthorized changes are made in the installation of the system. Improvement Permit with plat valid without expiration. Improvement Permit with site plan valid for sixty months. Authorization to Construct is valid for a period equal to that of Improvement Permit – not to exceed sixty months.

Signed Rick Dyson date

Improvement Permit by: Marvin H. Eaton date 3/20/98

Authorization to Construct by: STEVE HEDACK date 12-2-98

Installed by:

Operation Permit by: Jc Potter date 4-27-99

Existing System Inspection by: date

HEALTH DEPT. COPY: WHITE INSPECTION COPY (FINAL): GREEN OWNER COPY (FINAL): YELLOW INSPECTION COPY (INITIAL): PINK OWNER COPY (INITIAL): GOLD