IREDELL COUNTY HEALTH DEPARTMENT - *ENVIRONMENTAL HEALTH* ☐ STATESVILLE OFFICE 704-878-5305 ☐ MOORESVILLE OFFICE 704-664-5281

IMPROVEMENT PERMIT / AUTHORIZATION TO CONSTRUCT / OPERATION PERMIT / EXISTING SYSTEM INSPECTION

PERMIT # _____ PIN # 4722-68-0626 DATE DECEMBER 21, 2010

OWNER SID L. HIGHFILL APPLICANT: _____ PHONE: Home/Cell # 704-528-7761 Business # 530-559-2152

SITE ADDRESS 237 Rumple Hill Drive, STVL OWNER / APPLICANT ADDRESS _____

SITE DIRECTIONS I-40 W, TL OLD MTN. RD, TL Rumple Hill DR, 7TH LOT on LEFT past St. Joseph's Ct. AT #237

SUBDIVISION LIPPARD SPRINGS BLOCK / SECTION IV LOT # 82 LOT AREA 0.65 Ac DESIGN FLOW 480 L.T.A.R. 0.30 GPD/FT²

Septic Tank 1000 Gallons: STB 1012 Date 5-6-98 ☐ New System ☐ Repair ☐ Expansion System Type I (II) III IV V VI ☑ Residence No. Bedrooms 4 Water Supply ☑ Private

Pump Tank _____ Gallons: P T _____ Date _____ System Description: CONVENTIONAL GRAVITY ☐ Business No. Persons _____ ☐ Public WELL

Pump Make _____ Model _____ Serial # _____ Repair System Description: RPBPS, LOW-PRESSURE ☐ Other No. Employees _____ ☐ Community


No. Nitrification Fields: 1 No. Lines 5 Linear Feet 533 Maintenance Agreement Required ☐ YES ☑ NO ☐ Slab ☑ Crawl Space

Trench Width 36" Max. Trench Bottom Depth 36" Gravel Depth 12" ☑ GRAVITY ☐ PRESSURE ☐ Basement w/plumbing ☐ Basement w/o plumbing


Comments / Conditions

APPROVED FOR MAXIMUM 30'x40' BUILDING SET AT 11' OFF REAR & LEFT SIDE PROPERTY LINES AS SHOWN. NO VEHICULAR TRAFFIC ALLOWED OVER SEPTIC SYSTEM

INITIAL SITE SKETCH

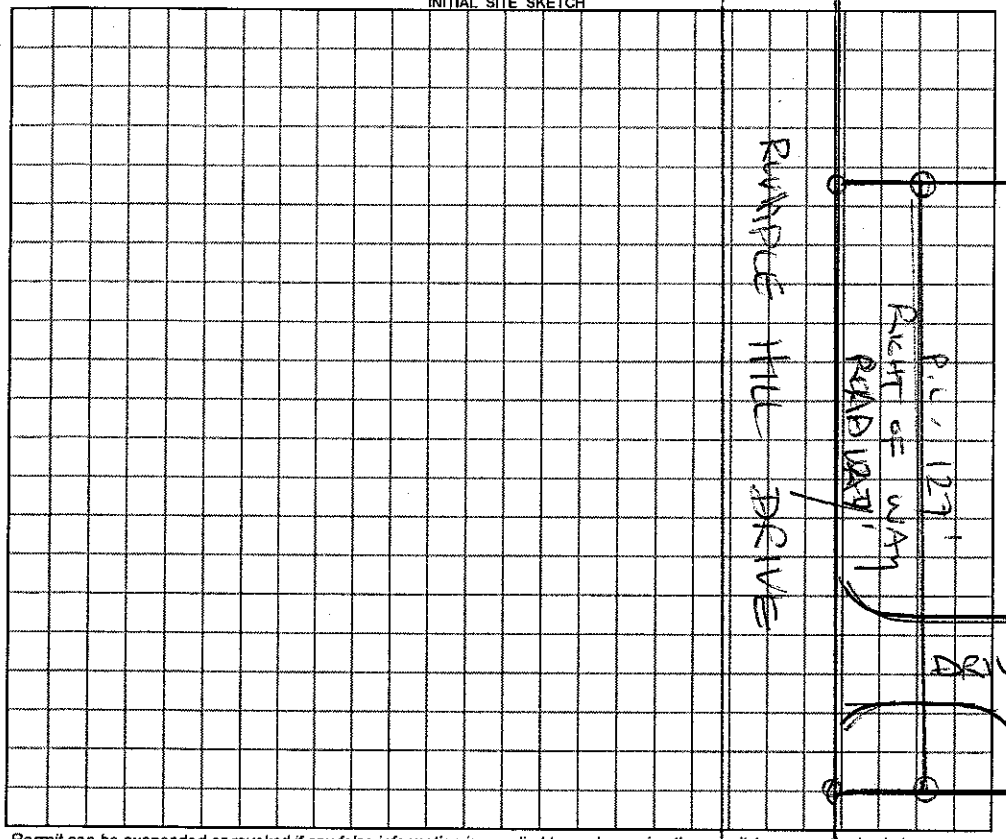

AS BUILT SKETCH

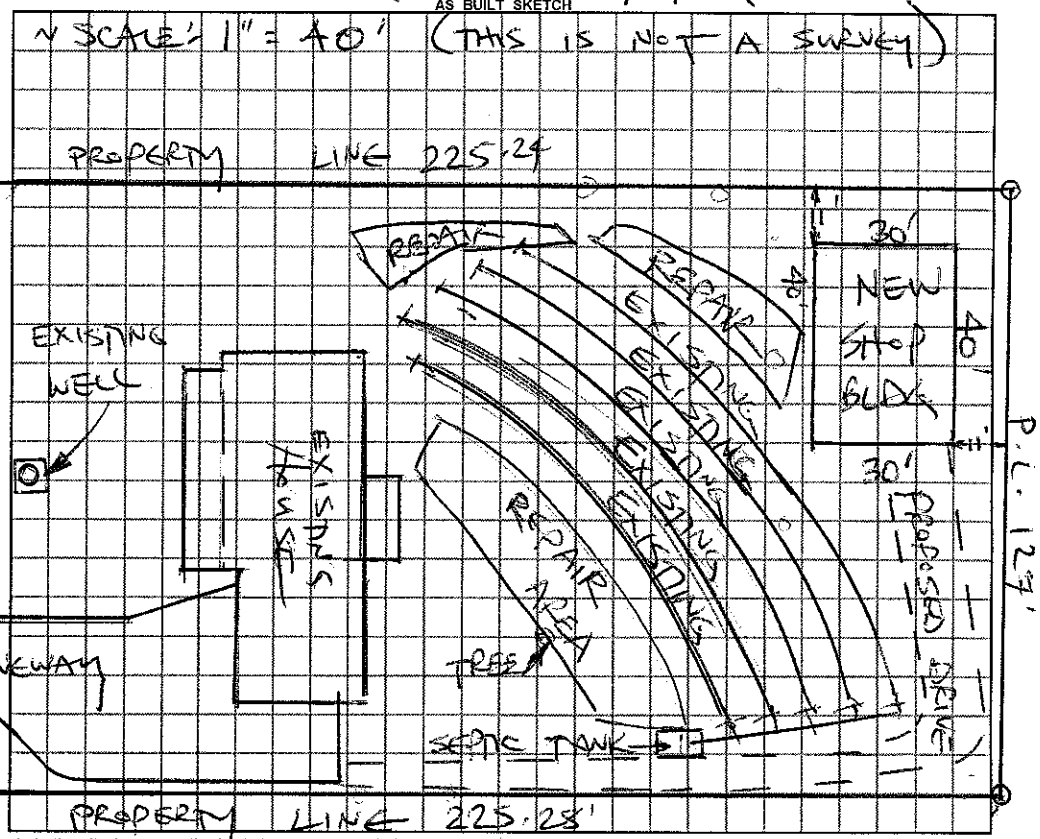

Permit can be suspended or revoked if any false information is supplied toward securing the permit / any unauthorized changes are made to the site / any unauthorized changes are made in the installation of the system.

☐ ***IMPROVEMENT PERMIT*** with plat valid without expiration. ☐ ***IMPROVEMENT PERMIT*** with plat valid without expiration. ☐ ***AUTHORIZATION TO CONSTRUCT*** valid for period equal to IMPROVEMENT PERMIT--not to exceed 60 mo.

Owner / Applicant Signature: _____ Date _____ Installed by: _____

IMPROVEMENT PERMIT by: _____ ***REHS*** Date _____ OPERATION PERMIT by: _____ ***REHS*** Date _____

AUTHORIZATION TO CONSTRUCT by: _____ ***REHS*** Date _____ Existing System Inspected by: STEVE HEDRICK ***REHS*** Date 12-21-2010

YOU SHOULD CONTACT A LOCATOR SERVICE PRIOR TO ANY EXCAVATION

White Copy – Environmental Health YELLOW COPY (Final) Owner / Applicant PINK COPY (Initial) Owner / Applicant