IREDELL COUNTY HEALTH DEPARTMENT

STATESVILLE 704-878-5305 MOORESVILLE 704-664-5281

IMPROVEMENT PERMIT / CERTIFICATE OF COMPLETION / OPERATION PERMIT / EXISTING SYSTEM INSPECTION

PROPERTY DESCRIPTION NO. ~~25-15~~ 06851 DATE 10-14-96 TAX MAP NO. 6c-6-A-51 Watershed: ☐ Yes ☐ No

OWNER OR CONTRACTOR Heritage Building PHONE: Business 528-6644 Home

ADDRESS 120 Hickory Point Ct. Statesville

LOCATION Buffalo Shoals TL oil min TL Rumple TR Stonefield 6th lot left

SUBDIVISION Lippard Sp. BLOCK / SECTION LOT 51 LOT AREA 125X225 SITE CLASS. PS DESIGN FLOW 360 L.T.A.R. .3

Septic Tank: 1000 Gallons: STB 1012 Date 3-8-97

Pump Tank: Gallons; PT Date

Pump Make: Model Serial No.

Nitrification Field: No Fields 1 Square Feet 1200 Linear Feet 400

No Lines 3 Trench Width 36" Max Trench Bottom Depth 36" Gravel Depth 12"

☑ New System ☐ Repair System Type: I, II, III, IV, V, VI

System Description: Con Gravity

Repair System Description: Pump To Chambers

Maintenance Agreement Required: ☐ Yes ☑ No

☑ House/Mod. Home No. Bedrooms 3

☐ Mobile Home No. Bathrooms 2

☐ Business No. Employees

☐ Other


☐ Slab ☑ Crawl Space ☐ Basement w/plumbing ☐ Basement wo/plumbing

Water Supply: ☑ Individual ☐ Community ☐ Public


Comments:

Comments:

INITIAL SITE SKETCH

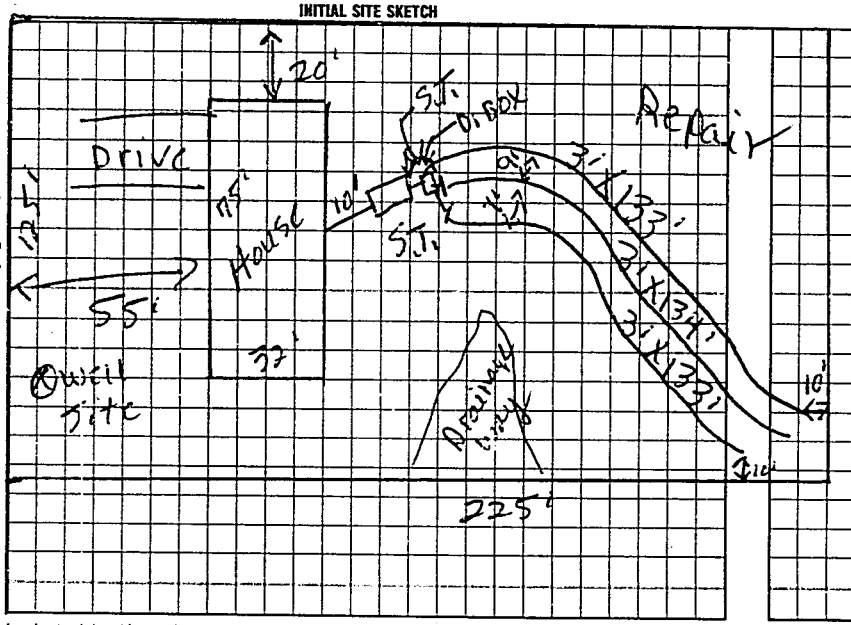

AS BUILT SKETCH

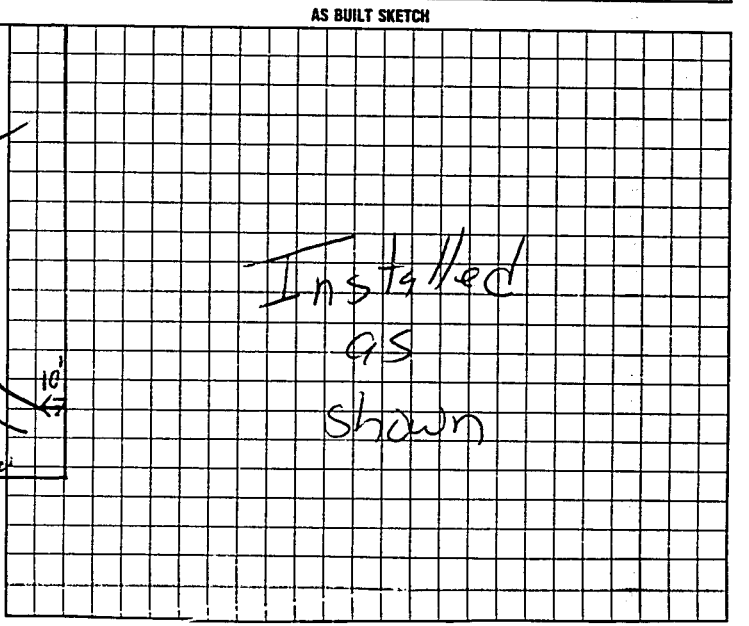

I understand that this permit can be suspended or revoked if any false information is supplied toward securing the permit/any unauthorized changes are made to the site/any unauthorized changes are made in the installation of the system.

Signed:

Improvement Permit by: E.C. moore date 10-14-96

Authorization to Construct by: E.C. moore date 10-14-96

Installed by: Tommy Frye

Certificate of Completion by: date

Operation Permit by: Mark C. Oakes date 5-8-97

HEALTH DEPT. COPY: WHITE INSPECTION COPY (FINAL): GREEN OWNER COPY: YELLOW to Construction Supervisor INSPECTION COPY (INITIAL): PINK OWNER COPY (INITIAL): GOLD

0 0 1 1 2 3