THIS PERMIT VOIDS PREVIOUS ISSUED 3/19/98

IREDELL COUNTY HEALTH DEPARTMENT

STATESVILLE 704-878-5305 MOORESVILLE 704-664-5281

IMPROVEMENT PERMIT / AUTHORIZATION TO CONSTRUCT / OPERATION PERMIT / EXISTING SYSTEM INSPECTION

PERMIT# 071344 PIN# 4772672705 (PART) DATE 2-25-99

OWNER OR CONTRACTOR HERITAGE BUILDING CO. PHONE: Business 902-0880 Home 528-6644

ADDRESS 120 HICKORY PLACE COURT, STATESVILLE NC 28677

LOCATION I-40 W TL OLD MTN ROAD TL RUMPLE HILL DRIVE, ON RIGHT PAST ST. JOSEPH COURT

SUBDIVISION LIMBS SPRINGS BLOCK / SECTION IV LOT 98 LOT AREA 0.70 ACRE SITE CLASS PS DESIGN FLOW 480 L.T.A.R. 0.30 gpd/ft²

Septic Tank: 1000 Gallons: STB 1012 Date 1-9-99

Pump Tank: Gallons: PT Date

Pump Make: Model Serial No

Nitrification Field: No Fields 1 Square Feet 1600 Linear Feet 533'

No Lines FIVE Trench Width 36" Max Trench Bottom Depth 33" Gravel Depth 12"

✓ New System Repair System Type: I (II) III IV V

System Description: CONVENTIONAL GRAVITY

Repair System Description: PDBPS, LOW PRESSURE

Maintenance Agreement Required Yes ✓ No

✓ House/Mod. Home No. Bedrooms 4

Mobile Home No. Bathrooms 2½

Business No. Employees

Other


Slab ✓ Crawl Space Basement w/plumbing Basement wo/plumbing

Water Supply: (I) Individual [ ] Public [ ] Community WELL

Comments/Conditions:

Comments/Conditions SEPTIC TANK WITH RISERS INSTALLED WITH "POLYLOK" FILTER

SCALE: 1" = 40' INITIAL SITE SKETCH

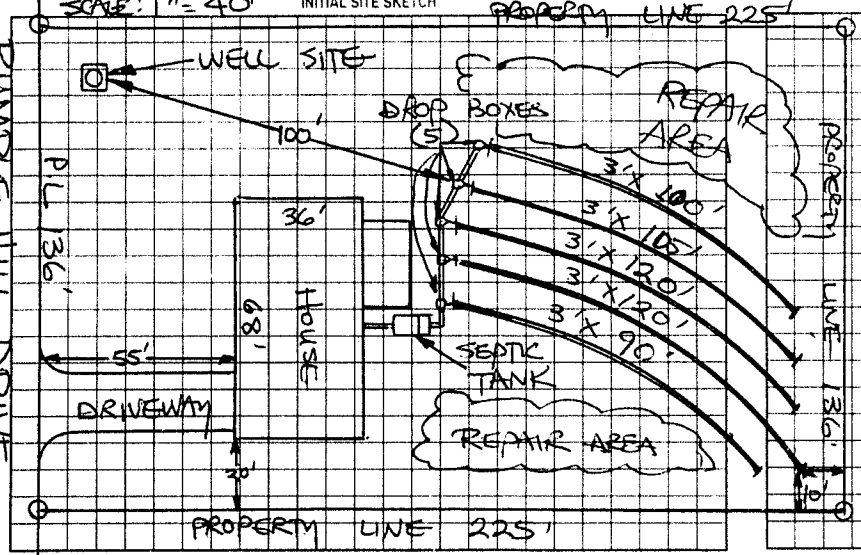

AS BUILT SKETCH

Installed as shown

Permit can be suspended or revoked if any false information is supplied toward securing the permit/any unauthorized changes are made to the site/any unauthorized changes are made in the installation of the system. Improvement Permit with plat valid without expiration. Improvement Permit with site plan valid for sixty months. Authorization to Construct is valid for a period equal to that of Improvement Permit – not to exceed sixty months.

Signed: [signature] 2-25-99 date

Installed by: Tommy Frye

Improvement Permit by: STEVE HEDRICK date 2-25-99

Operation Permit by: [signature] REHS date 3-19-99

Authorization to Construct by: STEVE HEDRICK date 2-25-99

Existing System Inspection by: date

HEALTH DEPT COPY WHITE OWNER COPY (FINAL) YELLOW OWNER COPY (INITIAL) PINK