Britt Bass 704-507-5462 This Permit Replaces Previous Permit Issued 10-1-07

IREDELL COUNTY HEALTH DEPARTMENT

STATESVILLE 704-878-5305 (or) MOORESVILLE 704-664-5281

IMPROVEMENT PERMIT / AUTHORIZATION TO CONSTRUCT / OPERATION PERMIT / EXISTING SYSTEM INSPECTION

PERMIT# 140089 PIN# 4722 69 ~~5 036 4856~~ 81876 DATE 11-7-08

OWNER OR APPLICANT MOUNTAIN Creek Investments LLC PHONE: Business 704-202-4964 Home

ADDRESS 125 Whaling Drive Mooresville NC 28117

LOCATION OLD NEWELL North (R) Buffalo Shoals (R) Davidson (L) Winding Cedar on LEFT

SUBDIVISION DAVIDSON WOODS BLOCK / SECTION 3 LOT 56 LOT AREA 1.683 AC SITE CLASS. PS DESIGN FLOW 360 L.T.A.R. 1.3

Septic Tank: 1000 Gallons: STB 794 Date 2-13-08

Pump Tank: 1000 Gallons: PT 27 Date 3-16-09

Pump Make: Goulds Model 1CPE5IM Serial No. B090570S

Nitrification Field: No Fields 1 Square Feet ER=1200 Linear Feet 300'

No Lines 3X100' Trench Width 36" Max Trench Bottom Depth 36"

(X) New System ( ) Repair ( ) Expansion System Type: I II (III) IV V VI

System Description: 25% REDUCTION SM

Repair System Description: LP PBGS

Maintenance Agreement Required: ( ) Yes (X) No

Gravel Depth NA ( ) Gravity (X) Pressure (X) Slab (X) Crawl Space ( ) Basement w/plumbing ( ) Basement wo/plumbing

(X) House/Mod. Home No. Bedrooms 3

( ) Mobile Home No. Persons 6

( ) Business No. Employees

( ) Other

Water Supply: (X) Individual ( ) Public ( ) Community

Comments/Conditions: (1) FOUNDATION IN PLACE AT TIME OF RELAYOUT (2) HOUSE IS 16' OFF THE Northeast P/L & 20' OFF North WEST P/L. FOUNDATION IS IN BOX Given By LSS DRAWING. [illegible] (3) BACKFILL For Positive Drainage AWAY FROM SD SEPTIC FIELD SETBACKS CAN BE MAINTAINED. DO NOT CUT OR PERMIT COULD BE VOID (4) SHAVE BERMS IN SYSTEM AREA

INITIAL SITE SKETCH

SET ATTACHED SYSTEM AS REVISED BY REVISED SOIL & ENVIRONMENTAL. ALL SEPTIC LINES ARE 10' OFF MARKED P/L'S Supply Lines are 5' OFF MARKED P/L'S CUT Interfered WITH Repair AREA. Add extra Line in above and below as drawn on permit per supervisors instructions, after appeal.

NEEDS BUILDERS Permission to Authorize Changes

AS BUILT SKETCH

(5) TANKS moved TO BACK OF HOME (6) House width is wider than box given but septic lines are not affected.

R = Repair
I = Initial

NO PATIO Think of deck

Permit can be suspended or revoked if any false information is supplied toward securing the permit/any unauthorized changes are made to the site/any unauthorized changes are made in the installation of the system. Improvement Permit with plat valid without expiration ( ) Improvement Permit with site plan valid for sixty months (X) Authorization to Construct is valid for a period equal to that of Improvement Permit – not to exceed sixty months.

Signed: [signature] date 11/12/08

Improvement Permit by: [signature] date 11-7-08


Authorization to Construct by: [signature] date 11-7-08

Installed by: 1019 Bass Loading Inc

Operation Permit by: [signature] date 5-21-09

Existing System Inspection by: date

HEALTH DEPT. COPY: WHITE OWNER COPY (FINAL): YELLOW OWNER COPY (INITIAL): PINK

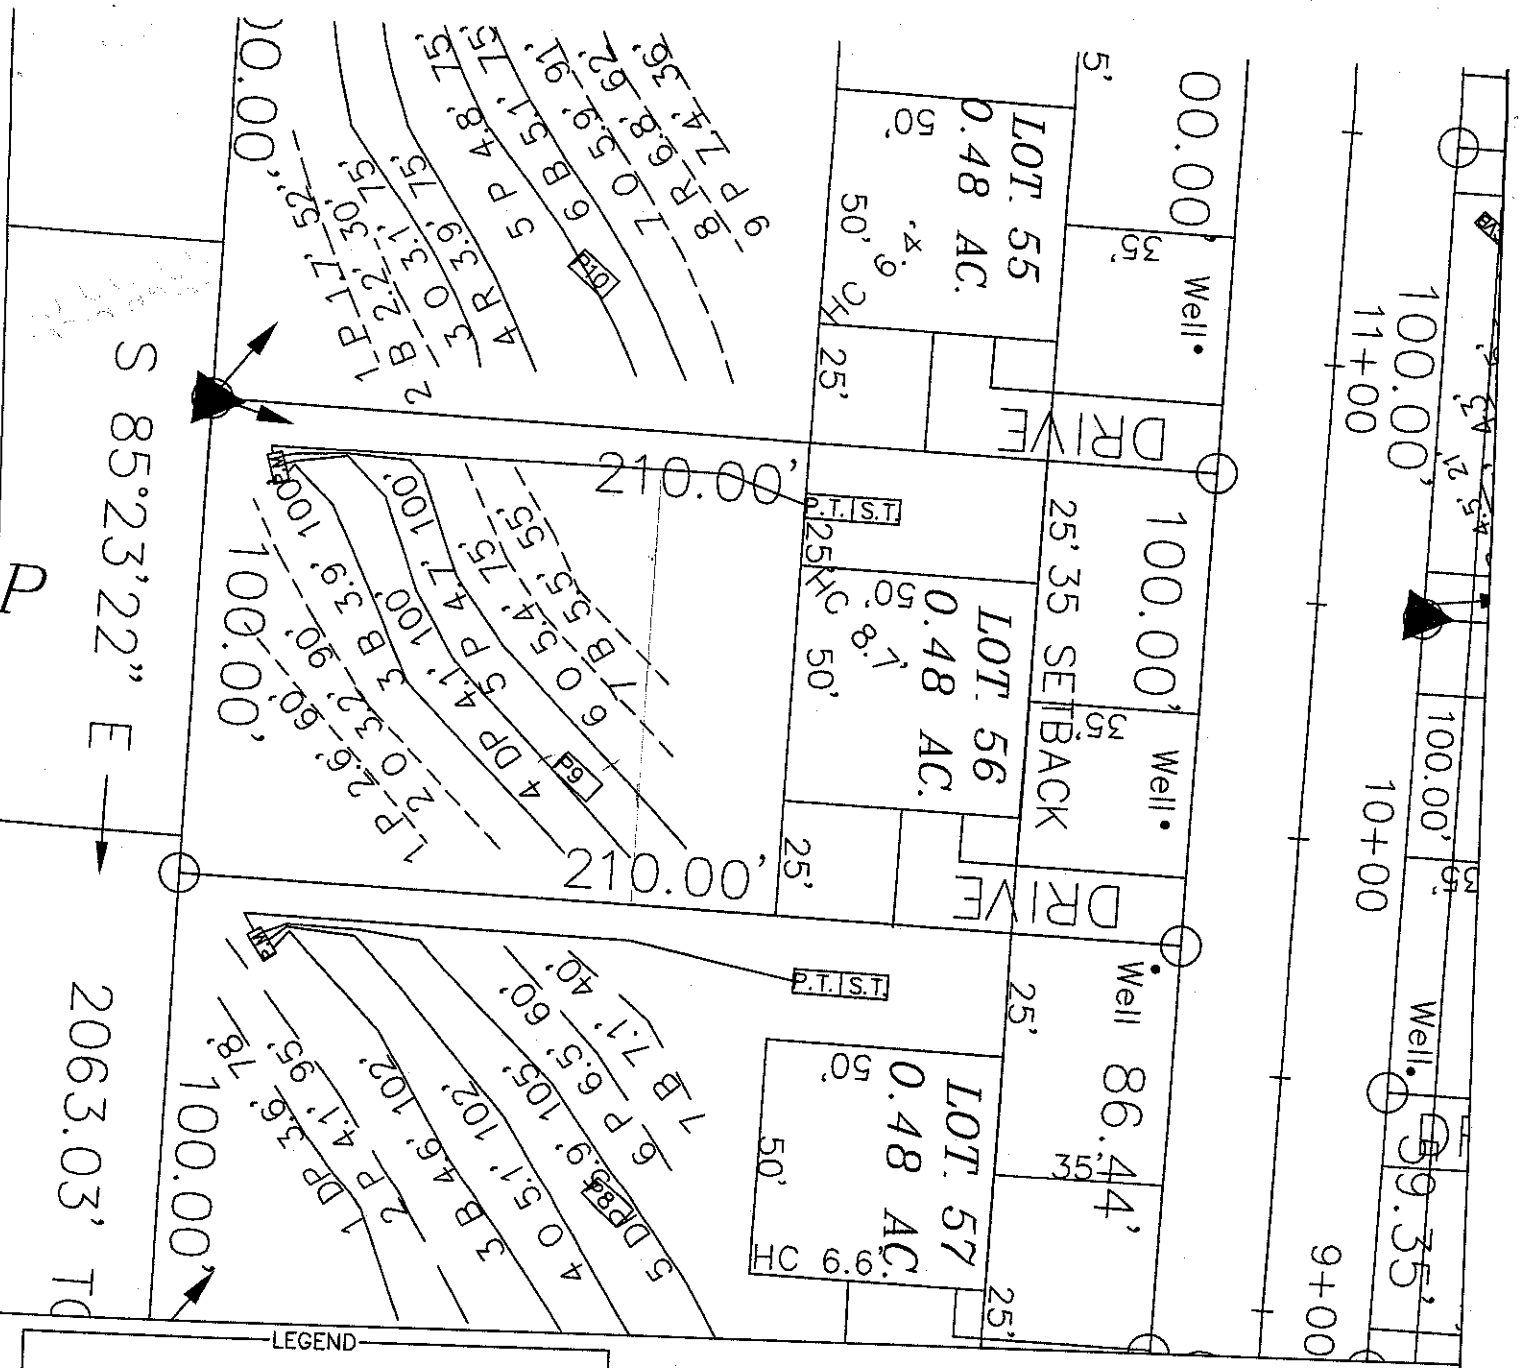

ROLLANS SOIL & ENVIRONMENTAL SERVICES
2120 GRAHAM ROAD
MOUNT ULLA, NC 28125
PHONE/FAX: (704) 278-0989
ASHLEY ROLLANS, NC LICENSED SOIL SCIENTIST
MOBILE: (704) 746-5046
EMAIL: ROLLANSFORTC@AOL.COM

MAP TITLE: SITE PLAN & DRAINFIELD AREAS

PROJECT NAME: Max Speer / Davidson Woods Phase II

LOCATION/DATE: WINDING CEDAR DRIVE, IREDELL COUNTY, NORTH CAROLINA, Febuary 2007

JOB # : 01-1308
FILE: C:\JOBS\01-1308
PROJECT MGR.: S.A.R.
FIELD WORK: S.A.R.
DRAWN BY: S.A.R.