IREDELL COUNTY HEALTH DEPARTMENT

STATESVILLE 704-878-5305 MOORESVILLE 704-664-5281

IMPROVEMENT PERMIT / CERTIFICATE OF COMPLETION / OPERATION PERMIT / EXISTING SYSTEM INSPECTION

PROPERTY DESCRIPTION NO. 071343 DATE 3-18-98 TAX MAP NO. 4772672705 (PT) Watershed: ☐ Yes ☒ No

OWNER OR CONTRACTOR Heritage Bldg Co. PHONE: Business (704) 528-6614 Home

ADDRESS 120 Hickory Place Ct. Statesville NC 28677

LOCATION Old Mountain Rd TR 4 Rumple Hill Dr. on Rt before End

SUBDIVISION Lippard Spgs BLOCK / SECTION 4 LOT 97 LOT AREA .70 Acre SITE CLASS. PS DESIGN FLOW 360 gpd L.T.A.R. .3

Septic Tank: 1000 Gallons; STB 1012 Date 9-30-98

Pump Tank: Gallons; PT Date

Pump Make: Model Serial No.

Nitrification Field: No Fields 1 Square Feet 1200' Linear Feet 400'

No Lines 4 at 100' Trench Width 36" Max Trench Bottom Depth 30" Gravel Depth 12"

☒ New System ☐ Repair System Type: I, (II), III, IV, V, VI

System Description: Gravity Conventional

Repair System Description: Grav/Pump Plastic Chamber or Sm. Tr.

Maintenance Agreement Required: ☐ Yes ☒ No

☒ House/Mod. Home No. Bedrooms 3

☐ Mobile Home No. Bathrooms 2

☐ Business No. Employees

☐ Other


☐ Slab ☒ Crawl Space ☐ Basement w/plumbing ☐ Basement wo/plumbing

Water Supply: ☒ Individual ☐ Community ☐ Public


Comments: Installer may use D-Box or Drop Boxes. Keep Septic System at least 10' from PL & 5' from house.

Comments:

INITIAL SITE SKETCH Scale 1:50

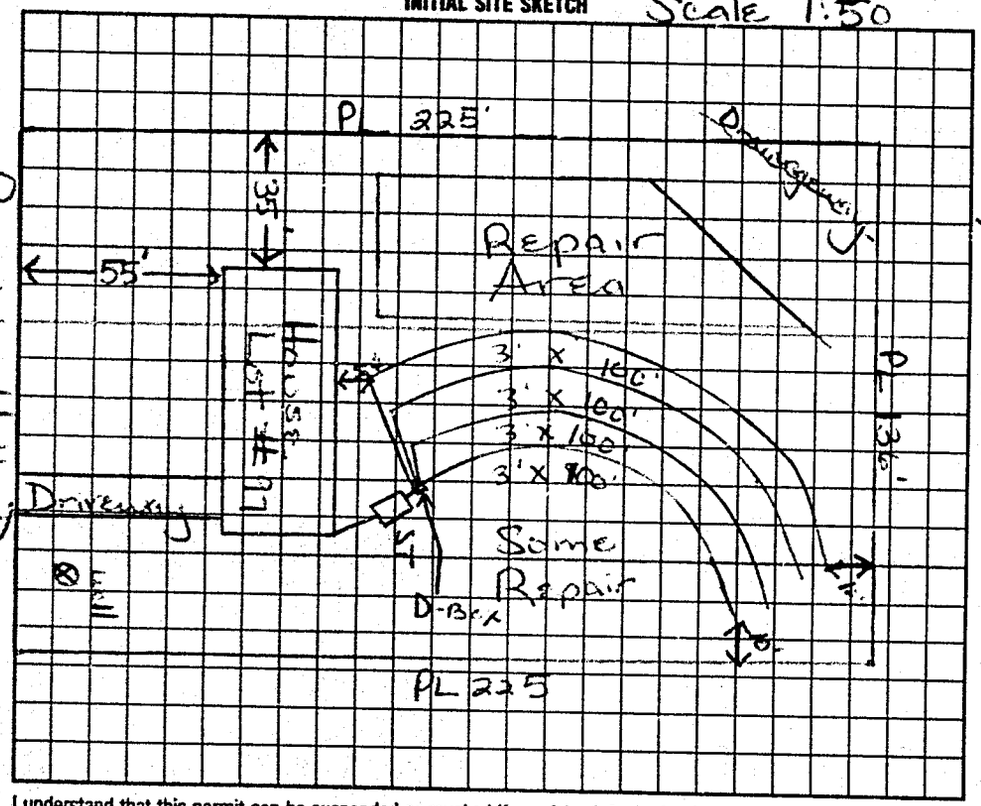

AS BUILT SKETCH

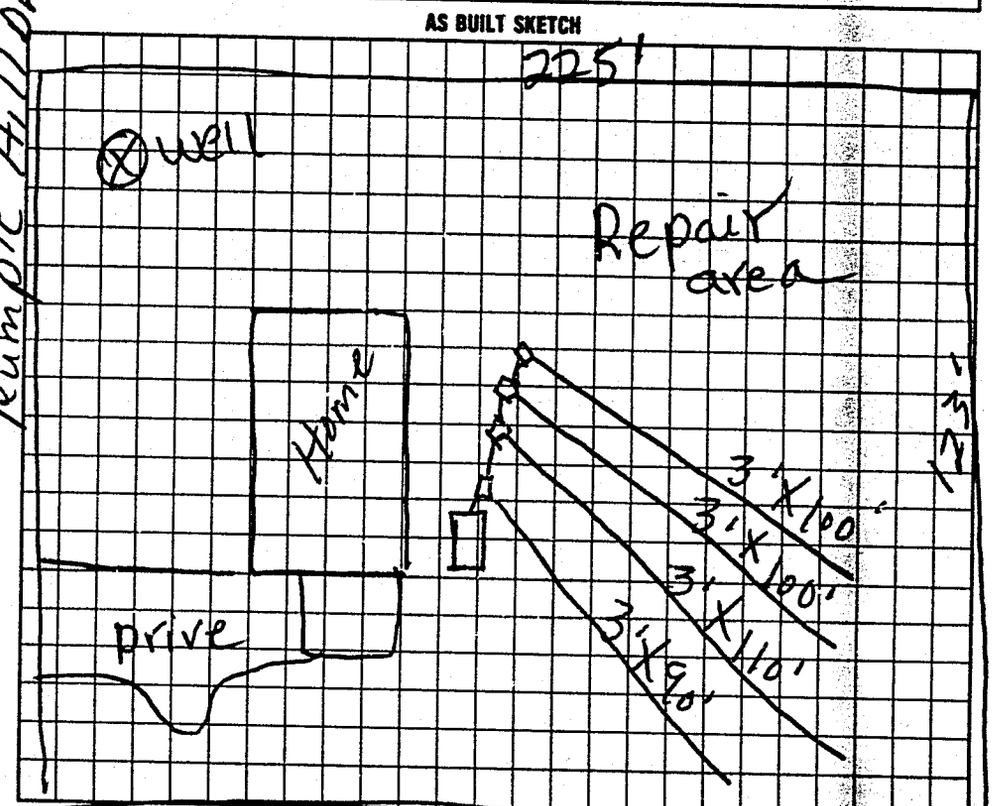

I understand that this permit can be suspended or revoked if any false information is supplied toward securing the permit/any unauthorized changes are made to the site/any unauthorized changes are made in the installation of the system. Improvement Permit is valid for 60 months from date of issuance.

Signed:

Improvement Permit by: Maria H. Dotson date 3/18/98

Existing System Inspection by: STEVE HEDRICK date 10-15-98

Installed by: Tommy Frye

Certificate of Completion by: date

Operation Permit by: R.C. moore date 12-9-98

HEALTH DEPT COPY: WHITE INSPECTION COPY (FINAL) GREEN OWNER COPY (FINAL) YELLOW INSPECTION COPY (INITIAL) PINK OWNER COPY (INITIAL) GOLD

Addl. Info Construct