IREDELL COUNTY HEALTH DEPARTMENT

THIS PERMIT VOIDS TWO PREVIOUS ISSUED 3/16/98 AND 3/17/98

STATESVILLE 704-878-5305 MOORESVILLE 704-664-5281

IMPROVEMENT PERMIT / AUTHORIZATION TO CONSTRUCT / OPERATION PERMIT / EXISTING SYSTEM INSPECTION

PERMIT# 093587 PIN# 4722 68 2665 / 3694 DATE 12-2-00

OWNER OR CONTRACTOR HERITAGE BLDG. CO. PHONE: Business 528-6644 Home

ADDRESS 120 HICKORY POINT CIR, STATESVILLE NC 28677

LOCATION OLD MOUNTAIN ROAD, TURN RUMPLE HILL DR, LOTS # 84 & 85 ON LEFT (SD BEFORE END)

SUBDIVISION LIZARD SPRINGS BLOCK / SECTION IV LOT 84/85 LOT AREA 1.30 ACRES SITE CLASS PS DESIGN FLOW 360 L.T.A.R. 0.30 GPD/FT²

Septic Tank: 1000 Gallons; STB 1012 Date 12-2-00

Pump Tank: ____ Gallons; PT ____ Date 2-28-01

Pump Make: ____ Model ____ Serial No. ____

Nitrification Field: No Fields 1 Square Feet 1200 Linear Feet 400

No Lines Four Trench Width 36" Max Trench Bottom Depth 30" Gravel Depth 12"

☑ New System ☐ Repair System Type: I, II, III, IV, V, VI

System Description: CONVENTIONAL GRAVITY

Repair System Description: CONVENTIONAL Pump

Maintenance Agreement Required: ☐ Yes ☑ No

☑ House/Mod. Home ☐ Mobile Home ☐ Business ☐ Other

No. Bedrooms 3 No. Bathrooms 2½ No. Employees ____

☐ Slab ☑ Crawl Space ☐ Basement w/plumbing ☐ Basement wo/plumbing


Water Supply: ☑ Individual ☐ Public ☐ Community WELL

Comments/Conditions: KEEP SYSTEM MINIMUM 100 FEET FROM WELL

SCALE: 1" = 60'

Comments/Conditions:

INITIAL SITE SKETCH

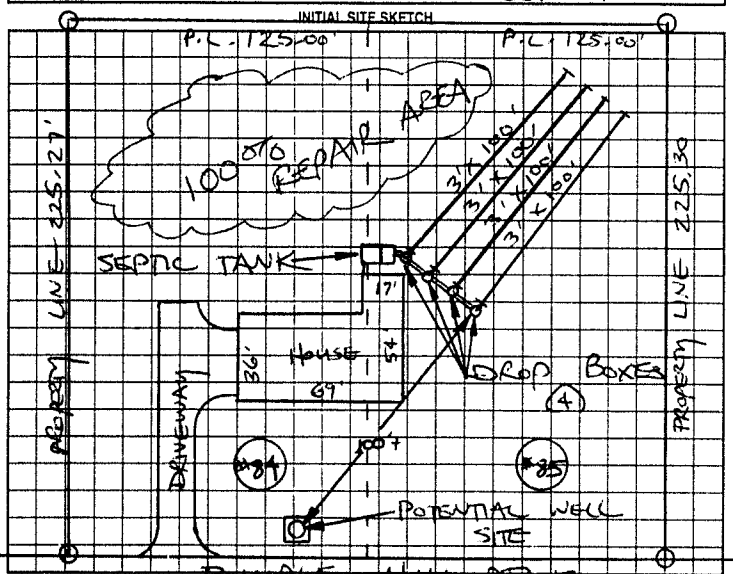

AS BUILT SKETCH

SYSTEM INSTALLED AS SHOWN WITH ROCKOK FILTER & MARKER

Permit can be suspended or revoked if any false information is supplied toward securing the permit/any unauthorized changes are made to the site/any unauthorized changes are made in the installation of the system. Improvement Permit with plat valid without expiration. Improvement Permit with site plan valid for sixty months. Authorization to Construct is valid for a period equal to that of Improvement Permit – not to exceed sixty months.

Signed: ____ date 12-4-00

Improvement Permit by: STEVE HEDRICK date 12-2-00

Authorization to Construct by: STEVE HEDRICK date 12-2-00

Installed by: TOMMY FOX

Operation Permit by: Jim Cook REHS date 4-27-01

Existing System Inspection by: ____ date ____

HEALTH DEPT. COPY: WHITE OWNER COPY (FINAL): YELLOW OWNER COPY (INITIAL): PINK