IREDELL COUNTY HEALTH DEPARTMENT

STATESVILLE 704-878-5305 (CI) MOORESVILLE 704-664-5281

IMPROVEMENT PERMIT / AUTHORIZATION TO CONSTRUCT / OPERATION PERMIT / EXISTING SYSTEM INSPECTION

PERMIT# 108891 PIN# 4722685377 DATE 3/7/03

OWNER OR CONTRACTOR ~~RW ROPER CONST~~ DAVID MEEHAN PHONE: Business 664-4449 Home

ADDRESS 105 DENVER BUSINESS PK MOORESVILLE

LOCATION ONR - TL RUMPLE HILL - AT END ON RT

SUBDIVISION LIPPARD SPRINGS BLOCK / SECTION 4 LOT 95 LOT AREA 1.89AC SITE CLASS PS DESIGN FLOW 360GPD L.T.A.R. .3600 FT2

Septic Tank: 1000 Gallons; STB 325 Date 4-26-07
Pump Tank: 1000 Gallons; PT 302 Date 4-17-07
Pump Make: Zoeller Model N152 Serial No.
Nitrification Field: No Fields 1 Square Feet 900 Linear Feet 300
No Lines 3@100' Trench Width 36" Max Trench Bottom Depth 36" Gravel Depth N/A

☑ New System ☐ Repair System Type: I, II, (III), IV, V, VI
System Description: PUMP 25% REDUCTION
Repair System Description: SAME
Maintenance Agreement Required: ☐ Yes ☑ No

☑ House/Mod. Home No. Bedrooms 3
☐ Mobile Home No. Bathrooms 3
☐ Business No. Employees
☐ Other


☐ Slab ☑ Crawl Space ☐ Basement w/plumbing ☐ Basement wo/plumbing

Water Supply: ☑ Individual ☐ Public ☐ Community


Comments:/Conditions:

Comments:/Conditions:
Blue Filter

INITIAL SITE SKETCH 1"=50'

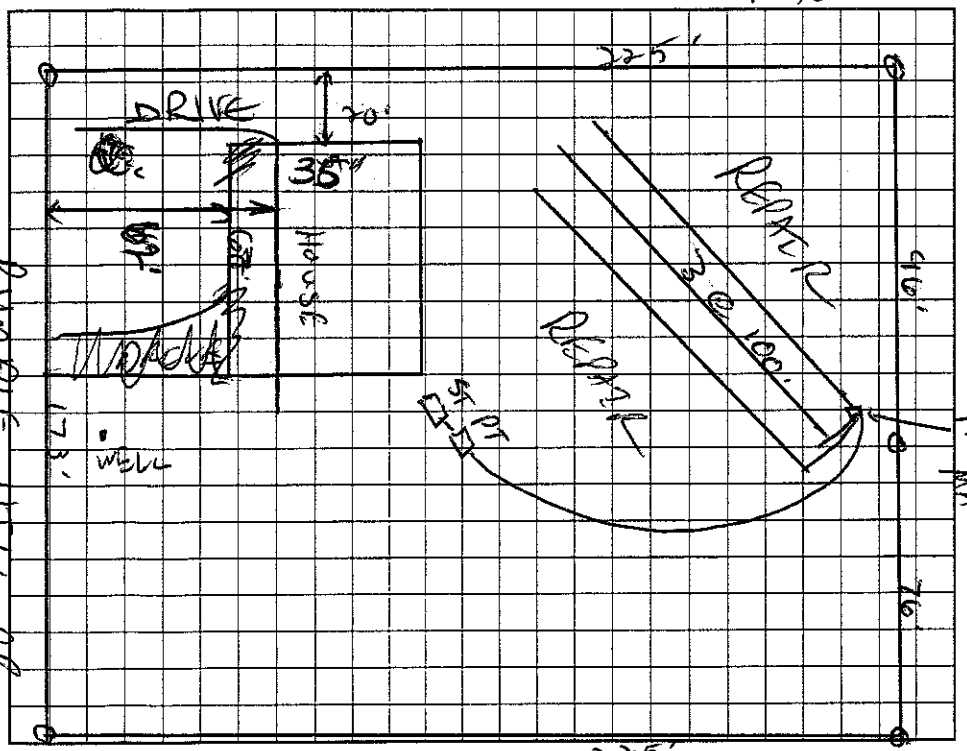

AS BUILT SKETCH

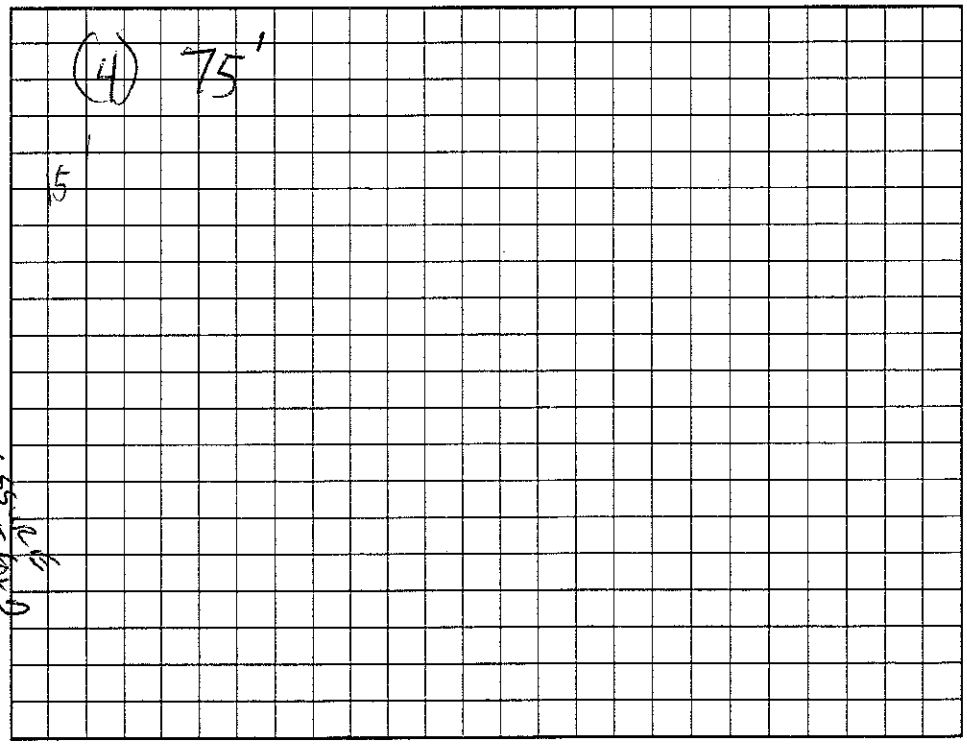

Permit can be suspended or revoked if any false information is supplied toward securing the permit/any unauthorized changes are made to the site/any unauthorized changes are made in the installation of the system. Improvement Permit with plat valid without expiration. Improvement Permit with site plan valid for sixty months. Authorization to Construct is valid for a period equal to that of Improvement Permit – not to exceed sixty months.

Signed: Russell Marcil date 8-11-03

Improvement Permit by: C. Hall KS date 3/7/03

Authorization to Construct by: STEVE HEDRICK date 3-8-07

Installed by: Rowan Septic

Operation Permit by: James Miller date 8-27-07

Existing System Inspection by: date

HEALTH DEPT. COPY: WHITE OWNER COPY (FINAL): YELLOW OWNER COPY (INITIAL): PINK