IREDELL COUNTY HEALTH DEPARTMENT

THIS PERMIT VOIDS PREVIOUS ISSUED 3-18-98

STATESVILLE 704-878-5305 MOORESVILLE 704-664-5281

IMPROVEMENT PERMIT / AUTHORIZATION TO CONSTRUCT / OPERATION PERMIT / EXISTING SYSTEM INSPECTION

PERMIT# 071340 PIN# 4772 67 2705 DATE 8-29-98

OWNER OR CONTRACTOR HERITAGE BLDG. CO. PHONE: Business Home 528-6644

ADDRESS 120 HICKORY PLACE COURT, STATESVILLE, NC 28677

LOCATION I-40W, TL OLD MTN. RD, TL RUMPLE HILL, LOT ON RIGHT JUST BEFORE CUL-DE-SAC

SUBDIVISION LIPPARD SPRINGS BLOCK / SECTION IV LOT 93 LOT AREA 0.69 ACRE SITE CLASS. PS DESIGN FLOW 360 L.T.A.R. 0.30 GPD/FT²

Septic Tank: 1000 Gallons; STB 1012 Date 8-11-98

Pump Tank: _____ Gallons; PT _____ Date _____

Pump Make: _____ Model _____ Serial No. _____

Nitrification Field: No Fields 1 Square Feet 1200 Linear Feet 400

No Lines THREE Trench Width 36" Max Trench Bottom Depth 36"+ Gravel Depth 12"

☑ New System ☐ Repair System Type: I, II, III, IV, V, VI

System Description: CONVENTIONAL GRAVITY

Repair System Description: CONVENTIONAL PUMP

Maintenance Agreement Required: ☐ Yes ☑ No

☑ House/Mod. Home No. Bedrooms 3

☐ Mobile Home No. Bathrooms 2

☐ Business No. Employees _____

☐ Other _____


☐ Slab ☑ Crawl Space ☐ Basement w/plumbing ☐ Basement wo/plumbing

Water Supply: ☑ Individual ☐ ~~Public~~ ☐ Community WELL


Comments:/Conditions: USE SPEED LEVELERS IN DISTRIBUTION BOX TO FEED UPPER LINES FIRST (FEEDING 3'x155' LINE LAST)

Comments:/Conditions:

INITIAL SITE SKETCH SCALE: 1"=40'

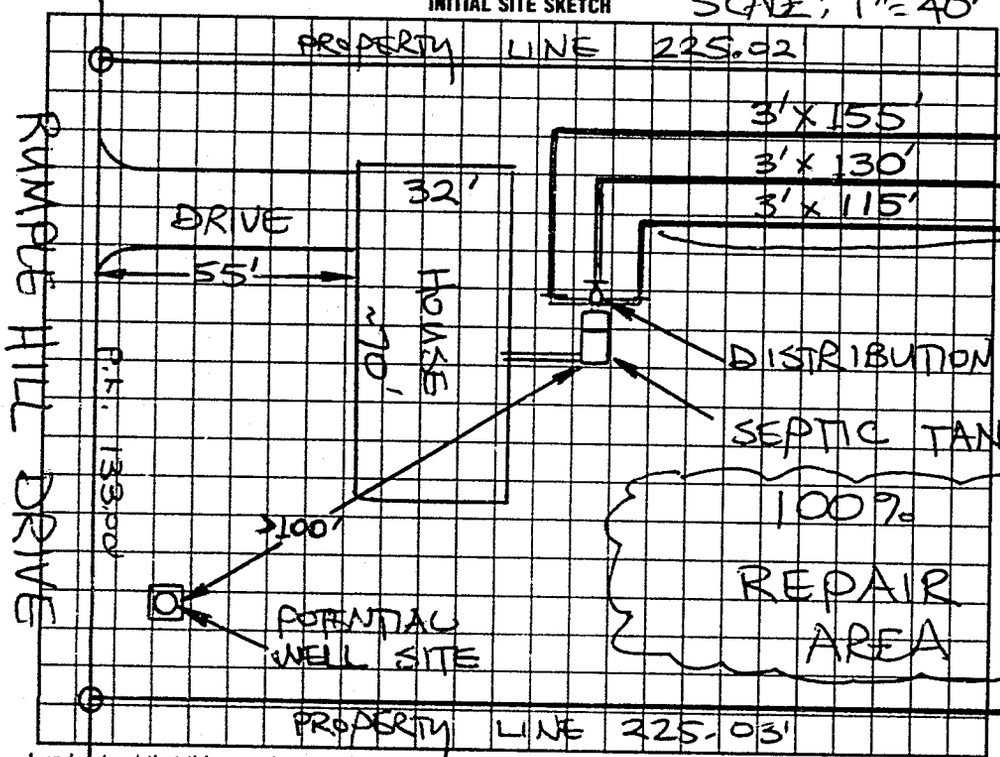

AS BUILT SKETCH

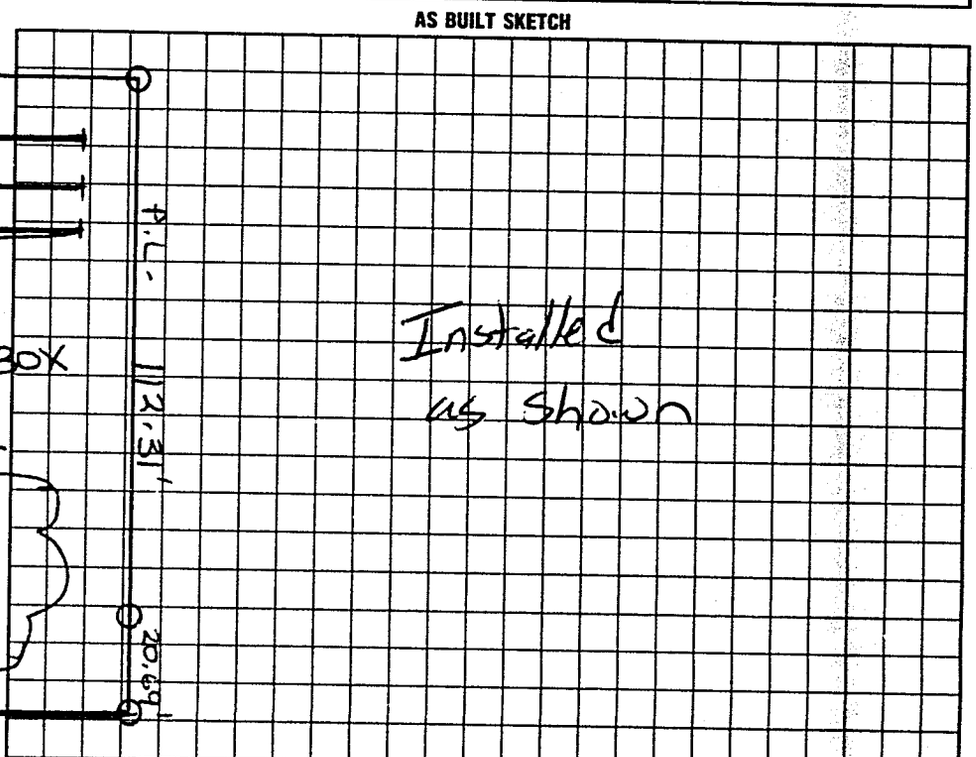

I understand that this permit can be suspended or revoked if any false information is supplied toward securing the permit/any unauthorized changes are made to the site/any unauthorized changes are made in the installation of the system. Improvement Permit with plat valid without expiration. Improvement Permit with site plan valid for sixty months. Authorization to Construct is valid for a period equal to that of Improvement Permit – not to exceed sixty months.

Signed: _____ date 8-31-98 Installed by: Tommy Fryar

Improvement Permit by: STEVE HEDRICK date 8-29-98 Operation Permit by: _____ date 10-14-98

Authorization to Construct by: STEVE HEDRICK date 8-29-98 Existing System Inspection by: _____ date _____

HEALTH DEPT. COPY WHITE INSPECTION COPY (FINAL) GREEN OWNER COPY (FINAL) YELLOW INSPECTION COPY (INITIAL) PINK OWNER COPY (INITIAL) GOLD