IREDELL COUNTY HEALTH DEPARTMENT

STATESVILLE 704-878-5305 (pl) MOORESVILLE 704-664-5281 (as)

IMPROVEMENT PERMIT / AUTHORIZATION TO CONSTRUCT / OPERATION PERMIT / EXISTING SYSTEM INSPECTION

PERMIT # 57870 PIN # 4722689684 DATE 8-18-09

OWNER or APPLICANT Liberty Homes PHONE: Business 704 599 1010 Home:

OWNER or APPLICANT ADDRESS JOMR; LT on Rumple Hill Rd; site on left

LOCATION / DIRECTIONS 281 ~~Liberty Homes~~ Rumple Hill Rd.

SUBDIVISION Lippard Springs BLOCK / SECTION 4 LOT # 89 LOT AREA .73 DESIGN FLOW 360 L.T.A.R. .3

Septic Tank 1000 Gallons: STB 794 Date 12-16-08

Pump Tank ____ Gallons: P T ____ Date ____

Pump Make ____ Model ____ Serial # ____

Nitrification Field No Fields 1 No Lines 4 Linear Feet 300

Trench Width 36" Max. Trench Bottom Depth 36" Gravel Depth n/a

☒ New System ☐ Repair ☐ Expansion System, Type I II III IV V VI

System Description: 25% Reduction Gravity

Repair System Description: 50% Reduction Pump

Maintenance Agreement Required ☐ YES ☒ NO

☒ GRAVITY ☐ PRESSURE

☒ Residence No. Bedrooms 3 ☐ Business No. Persons ____ ☐ Other No. Employees ____


☐ Slab ☐ Crawl Space ☒ Basement w/plumbing ☐ Basement w/o plumbing

Water Supply: ☒ Private ☐ Public ☐ Community

Comments / Conditions

Comments / Conditions

INITIAL SITE SKETCH

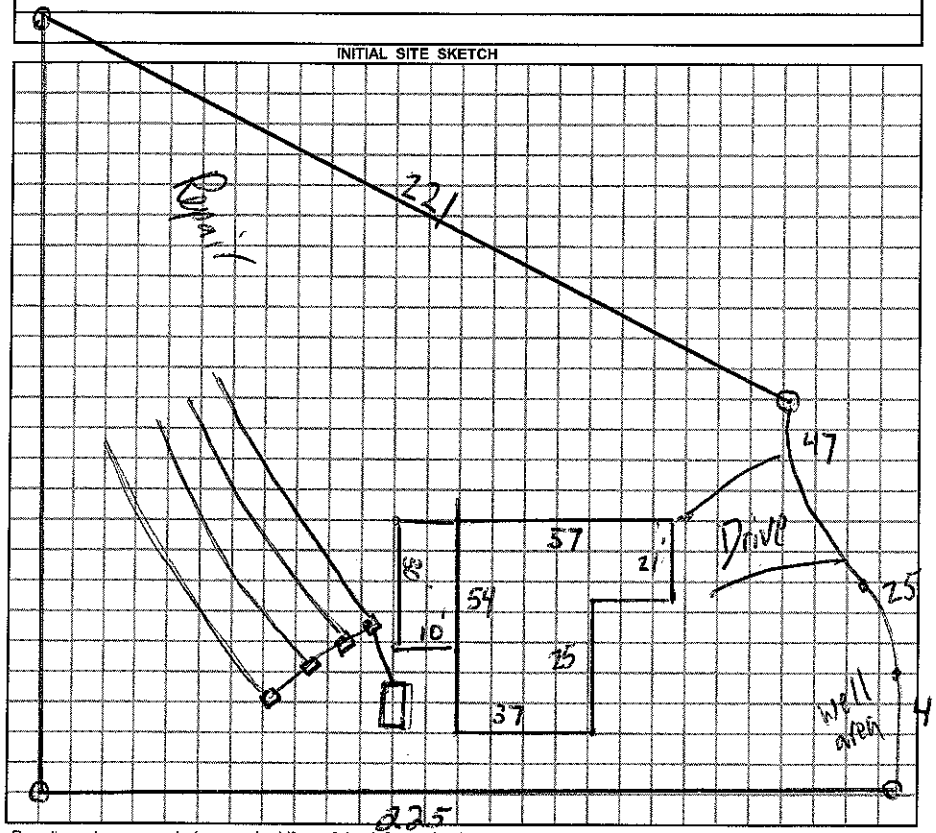

AS BUILT SKETCH

Permit can be suspended or revoked if any false information is supplied toward securing the permit / any unauthorized changes are made to the site / any unauthorized changes are made in the installation of the system.

☐ *IMPROVEMENT PERMIT w / plat valid without expiration.* ☒ *IMPROVEMENT PERMIT w / site plan valid for 60 mos.* ☒ *AUTHORIZATION TO CONSTRUCT valid for period equal to IMPROVEMENT PERMIT-not to exceed 60 mo.*

Owner / Applicant Signature: [signature] Date 8/19/09

Improvement Permit by: [signature] Date 8-18-09

Authorzation to Construct by: [signature] Date 8-18-09

Installed by: Abernathy

Operation Permit by: [signature] Date: 9-3-09

Existing System Inspected by: ____ Date: ____

YOU SHOULD CONTACT A LOCATOR SERVICE PRIOR TO ANY EXCAVATION.

WHITE COPY Environmental Health YELLOW COPY (Final) Owner / Applicant PINK COPY (Initial) Owner / Applicant