170684 EO

THIS PERMIT REPLACES PREVIOUS ISSUED 10/01/2007

IREDELL COUNTY HEALTH DEPARTMENT - *ENVIRONMENTAL HEALTH* ☐ STATESVILLE OFFICE 704-878-5305 ☐ MOORESVILLE OFFICE 704-664-5281

IMPROVEMENT PERMIT / AUTHORIZATION TO CONSTRUCT / OPERATION PERMIT / EXISTING SYSTEM INSPECTION

3:30

PERMIT # ~~14065 / 14066~~ PIN # 4722 69 3178 DATE FEBRUARY 9th, 2012

OWNER WAYNE CARRIGAN APPLICANT: ADRIAN PRUETT PHONE: Home/Cell # 704-202-5791 Business # 704-873-0389

SITE ADDRESS WINDING CEDAR DRIVE OWNER / APPLICANT ADDRESS

SITE DIRECTIONS BUFFALO SHOALS RD TO DAVIDSON ROAD, TR WINDING CEDAR DRIVE, IN CURVE NEAR END ON RIGHT

SUBDIVISION DAVIDSON WOODS BLOCK / SECTION 3 LOT # 43 & 44 LOT AREA ~1.41 ACRES DESIGN FLOW 360 L.T.A.R. 0.25 GPD/FT²

Septic Tank 1000 Gallons: STB 347 Date 1-15-12 ☑ New System ☐ Repair ☐ Expansion System Type I II (III) IV V VI ☑ Residence No. Bedrooms 3 Water Supply ☑ Private WELL

Pump Tank ____ Gallons: P T ____ Date ____ System Description: 25% REDUCTION, GRAVITY ☐ Business No. Persons ____ ☐ Public

Pump Make ____ Model ____ Serial # ____ Repair System Description: 50% REDUCTION ☐ Other No. Employees ____ ☐ Community


No. Nitrification Fields: 1 No. Lines FOUR Linear Feet 360 + Maintenance Agreement Required ☐ YES ☑ NO ☐ Slab ☑ Crawl Space

Trench Width 36" Max. Trench Bottom Depth 36" Gravel Depth N/A ☑ GRAVITY ☐ PRESSURE ☐ Basement w/plumbing ☐ Basement w/o plumbing


Comments / Conditions ① SEE "FAST TRACK" SPECIFICATION BY ADRIAN PRUETT ATTACHED. ② KEEP SYSTEM MINIMUM 100 FEET FROM WELL ③ INSTALL 25% REDUCTION SYSTEM ON CONTOUR AS SHOWN.

INITIAL SITE SKETCH

SCALE: 1"=60'

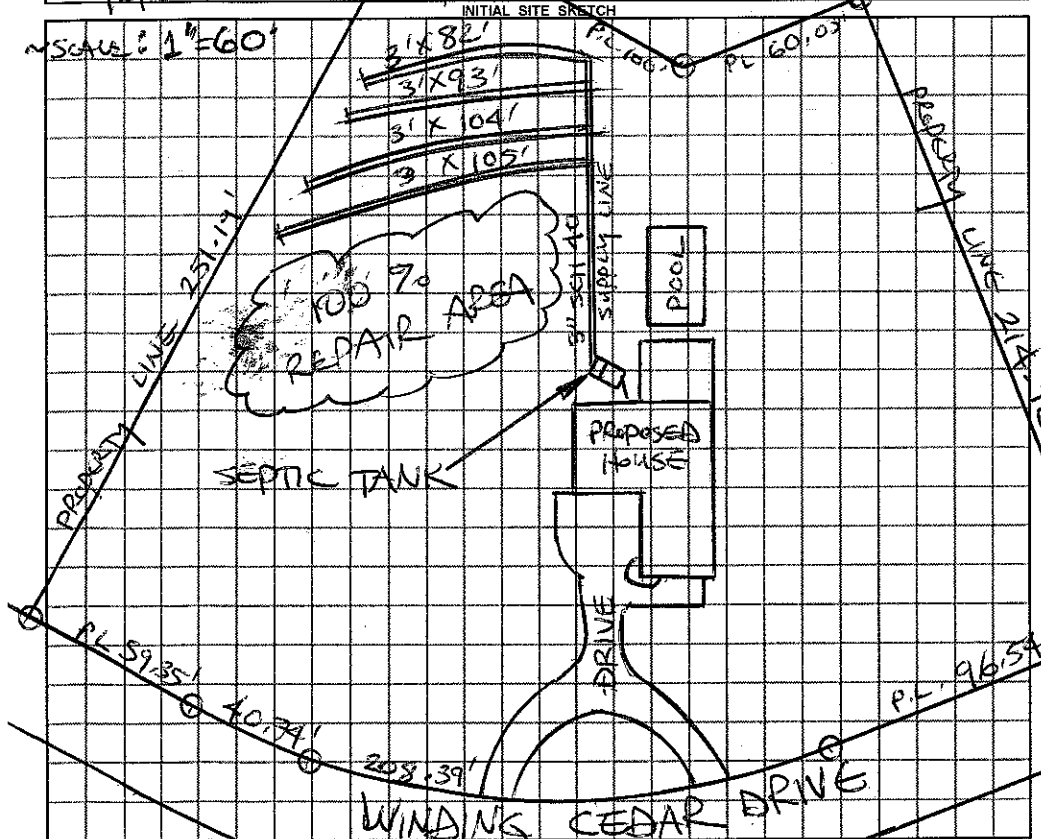

AS BUILT SKETCH

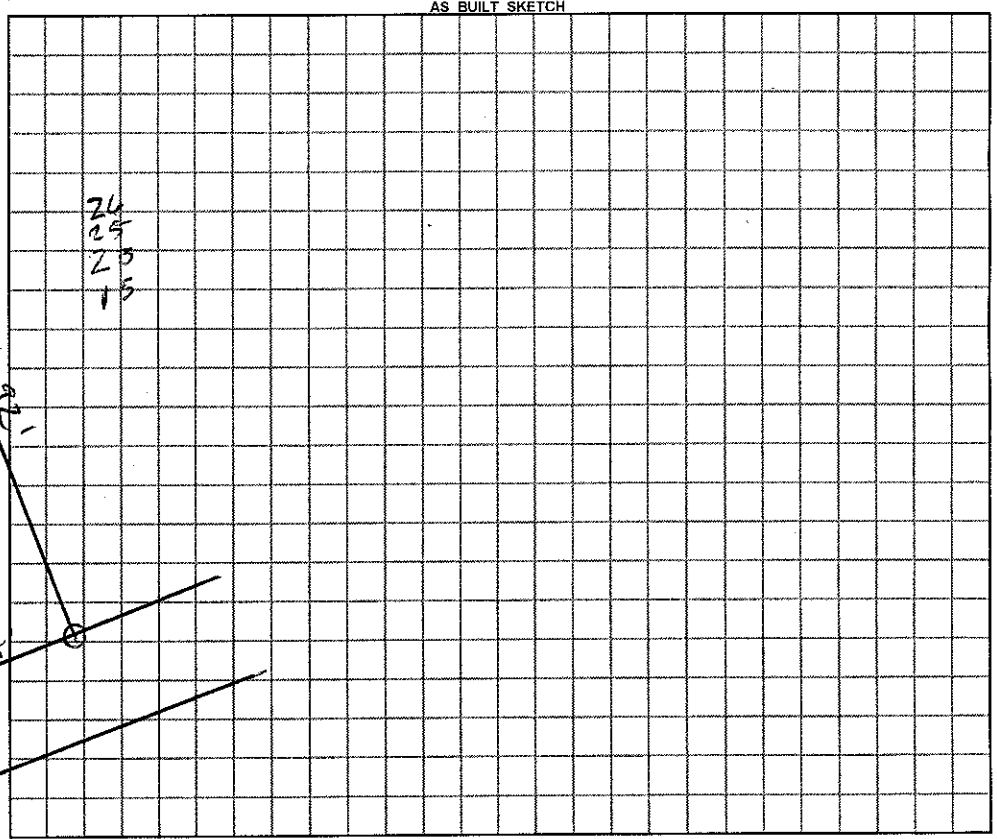

Permit can be suspended or revoked if any false information is supplied toward securing the permit / any unauthorized changes are made to the site / any unauthorized changes are made in the installation of the system.

☐ ***IMPROVEMENT PERMIT*** with plat valid without expiration. ☑ ***IMPROVEMENT PERMIT*** with plat valid without expiration. site plan valid 60 mo. ☐ ***AUTHORIZATION TO CONSTRUCT*** valid for period equal to IMPROVEMENT PERMIT--not to exceed 60 mo.

Owner / Applicant Signature: Wayne Carrig 2/14/12 Date 2/13/12 Installed by: Specialty Septic

IMPROVEMENT PERMIT by: STEVE HEDRICK REHS Date 2-9-2012 OPERATION PERMIT by: REHS Date 7-11-12

AUTHORIZATION TO CONSTRUCT by: REHS Date 2-14-12 Existing System Inspected by: REHS Date

YOU SHOULD CONTACT A LOCATOR SERVICE PRIOR TO ANY EXCAVATION

White Copy -- Environmental Health YELLOW COPY (Final) Owner / Applicant PINK COPY (Initial) Owner / Applicant