IREDELL COUNTY HEALTH DEPARTMENT

Statesville Office – Central Permitting (704) 878-5305 Mooresville Office (704) 660-3625


PRIVATE DRINKING WATER WELL PERMIT # 140115 **PIN #** 4722699078 **Type of Permit (circle one):** (New) Repair Abandonment

APPLICANT NAME: Clayton Homes ADDRESS: 1230 Conover Blvd West Conover PHONE: 828-465-3451?

DIRECTIONS TO SITE: Buffalo Shoals Rd TL Davidson Rd. TR Winding Cedar Dr.

SITE ADDRESS: 187 Winding Cedar Dr. SUBDIVISION: Davidson Woods SECTION/LOT: III / 63

Initial Site Sketch

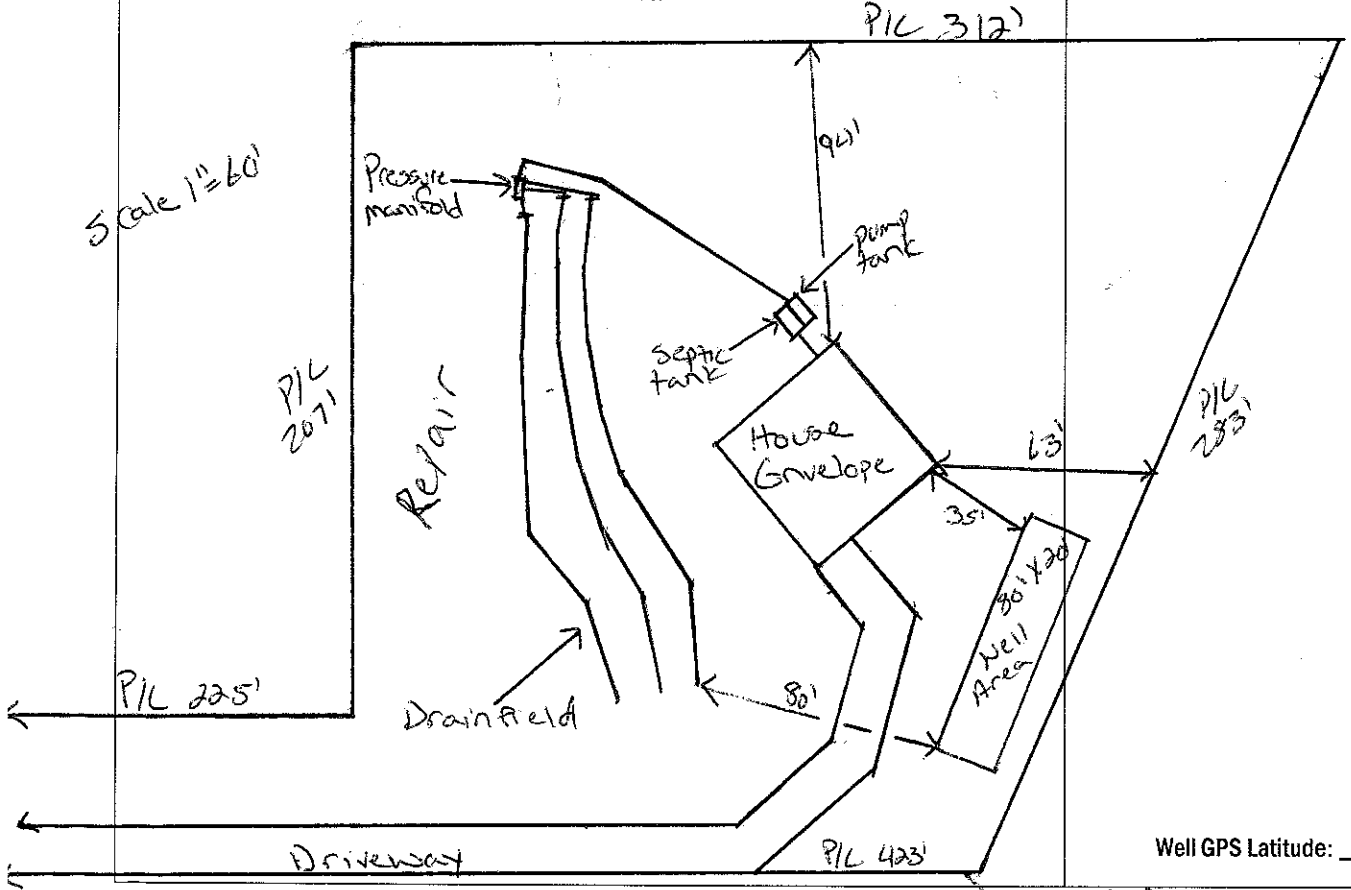

"As Built" Sketch

Well GPS Latitude: _____ Longitude: _____

PERMIT CONDITIONS/COMMENTS: Well area is a minimum of 25' from any building foundation. Well area is a minimum of 80' from all components of septic tank system

WELL PERMIT ISSUED BY: Jud Henderson DATE: 5-20-13 (Permit is valid for 5 years from date issued. This permit may be revoked if it is determined there has been a material change in any fact or circumstance upon which the permit is issued. Actions of the employees of the Iredell County Health Department shall in no way be taken as a guarantee that this well will produce water of any particular quantity or quality or for any amount of time. Employees of the Iredell County Health Department assume no liability for any damages, either direct or consequential which may be caused by this well.)

Well Contractor: Russell Well Drilling CONTRACTOR CERT #: 2231 A GROUT INSPECTION BY: [signature] DATE: 6-18-13

OR CERTIFICATION OF GROUT NOT WITNESSED BY DEPT: _____ DATE: _____ WELL HEAD INSPECTION BY: _____ DATE: _____

WELL HEAD INSPECTION (check when completed): GROUT TO GROUND SURFACE ☑ WELL CONTRACTOR ID PLATE ☑ PUMP INSTALLER ID PLATE ☑ SAMPLE PORT ☑

ACCESS PORT / VENT ☑ WELL SEAL ☑ WELL HEAD 12 INCHES / PITLESS ADAPTOR 8 INCHES ABOVE GRADE ☑

CERTIFICATE OF COMPLETION BY: [signature] DATE: 6-20-13 WATER SAMPLES BY: _____ DATE: _____

Attachments: Form GW-1a (required except for abandonment) ☐ Form GW-30 ☐ Water Sample Results ☐ Plat ☐

Health Dept. Copy – White Applicant Certificate of Completion – Yellow Applicant Well Construction Permit - Pink