IREDELL COUNTY HEALTH DEPARTMENT

STATESVILLE 704-878-5305 MOORESVILLE 704-664-5281

IMPROVEMENT PERMIT / CERTIFICATE OF COMPLETION / OPERATION PERMIT / EXISTING SYSTEM INSPECTION

PROPERTY DESCRIPTION NO. 21832 DATE 10-10-95 TAX MAP NO. 35-A-36 Watershed: [ ] Yes [X] No

OWNER OR CONTRACTOR CRYSTAL D. HALL PHONE: Business Home 528-3961

ADDRESS 651 OLD MOUNTAIN ROAD, STATESVILLE NC 28677

LOCATION I-40 W, TL OLD MOUNTAIN ROAD, MH ON (R) BETWEEN LIPPARD SPRINGS & TROUTMAN FARM RD

SUBDIVISION BLOCK / SECTION LOT LOT AREA 0.5 ACRES SITE CLASS PS DESIGN FLOW 480 L.T.A.R. EXISTING

Septic Tank: EXISTING Gallons; STB Date

Pump Tank: Gallons; PT Date

Pump Make: Model Serial No.

Nitrification Field: No Fields 1 Square Feet Linear Feet EXISTING

No Lines EXISTING Trench Width Max Trench Bottom Depth Gravel Depth

[ ] New System [ ] Repair System Type: [I] II. III. IV. V. VI

System Description: CONVENTIONAL GRAVITY

Repair System Description:

Maintenance Agreement Required: [ ] Yes [ ] No

[ ] Slab [X] Crawl Space [ ] Basement w/plumbing [ ] Basement wo/plumbing

[ ] House/Mod. Home No. Bedrooms 3

[X] Mobile Home No. Bathrooms 2

[ ] Business No. Employees

[ ] Other


Water Supply:
[X] Individual
[ ] Community
[ ] Public
WELL

Comments:

Comments:

INITIAL SITE SKETCH

AS BUILT SKETCH

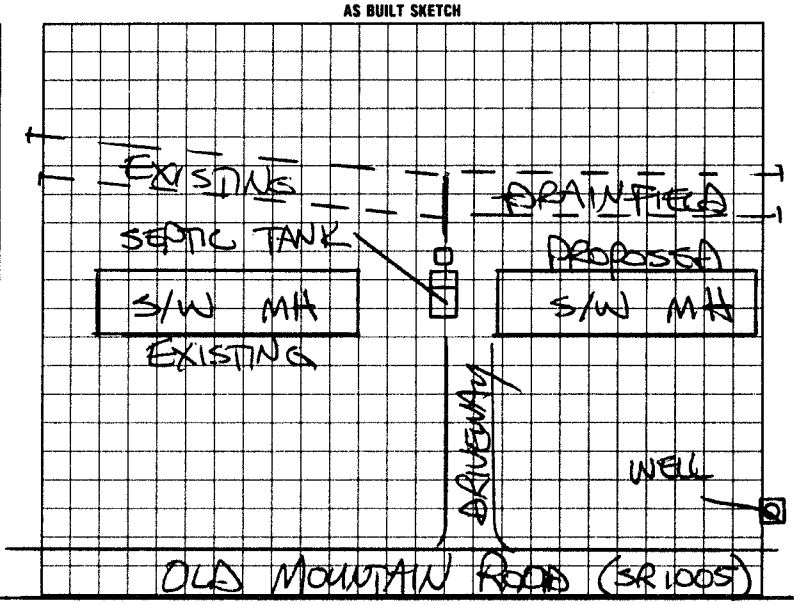

I understand that this permit can be suspended or revoked if any false information is supplied toward securing the permit/any unauthorized changes are made to the site/any unauthorized changes are made in the installation of the system.

Signed:

Improvement Permit by: date

Existing System Inspection by: STEVE HEDRICK date 10/10/95

Installed by:

Certificate of Completion by date

Operation Permit by: date

HEALTH DEPT. COPY: WHITE INSPECTION COPY (FINAL): GREEN OWNER COPY (FINAL): YELLOW INSPECTION COPY (INITIAL): PINK OWNER COPY (INITIAL): GOLD