IREDELL COUNTY HEALTH DEPARTMENT

STATESVILLE 704-878-5305 MOORESVILLE 704-664-5281

IMPROVEMENT PERMIT / AUTHORIZATION TO CONSTRUCT / OPERATION PERMIT / EXISTING SYSTEM INSPECTION

PERMIT# 108935 PIN# 4722 770121 DATE 3/7/03

OWNER OR CONTRACTOR RW FORCE CONS. PHONE: Business Home

ADDRESS 105 DENVER BUSINESS MOORESVILLE NC

LOCATION OMR-JL RUMPLE HILL - JR LIPPARD SPRINGS CIRCLE - ON RT

SUBDIVISION LIPPARD SPRINGS BLOCK / SECTION 7 LOT 125 LOT AREA .64AC SITE CLASS. PS DESIGN FLOW 360GPD L.T.A.R. .36PD/FT²

Septic Tank: 1000 Gallons; STB 1017 Date 11-14-05

Pump Tank: Gallons; PT Date

Pump Make: Model Serial No.

Nitrification Field: No Fields 1 Square Feet 900 Linear Feet 300

No Lines 3@100' Trench Width 36" Max Trench Bottom Depth 36" Gravel Depth N/A

☑ New System ☐ Repair System Type: I, II, (III), IV, V, VI

System Description: GRAVITY 25% REDUCTION

Repair System Description: LP PANEL

Maintenance Agreement Required: ☐ Yes ☑ No

☑ House/Mod. Home No. Bedrooms 3

☐ Mobile Home No. Bathrooms 3

☐ Business No. Employees

☐ Other


☐ Slab ☑ Crawl Space ☐ Basement w/plumbing ☐ Basement wo/plumbing

Water Supply: ☑ Individual ☐ Public ☐ Community


Comments/Conditions:

Comments/Conditions: TUFFTITE FITTINGS

INITIAL SITE SKETCH 1" = 50'

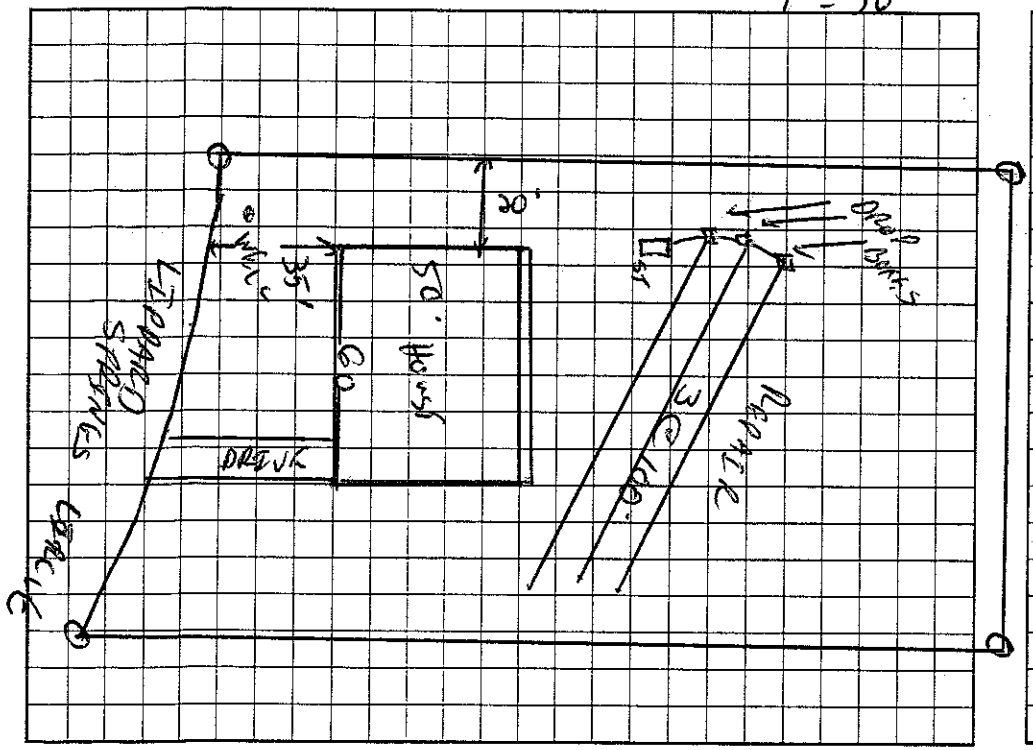

AS BUILT SKETCH

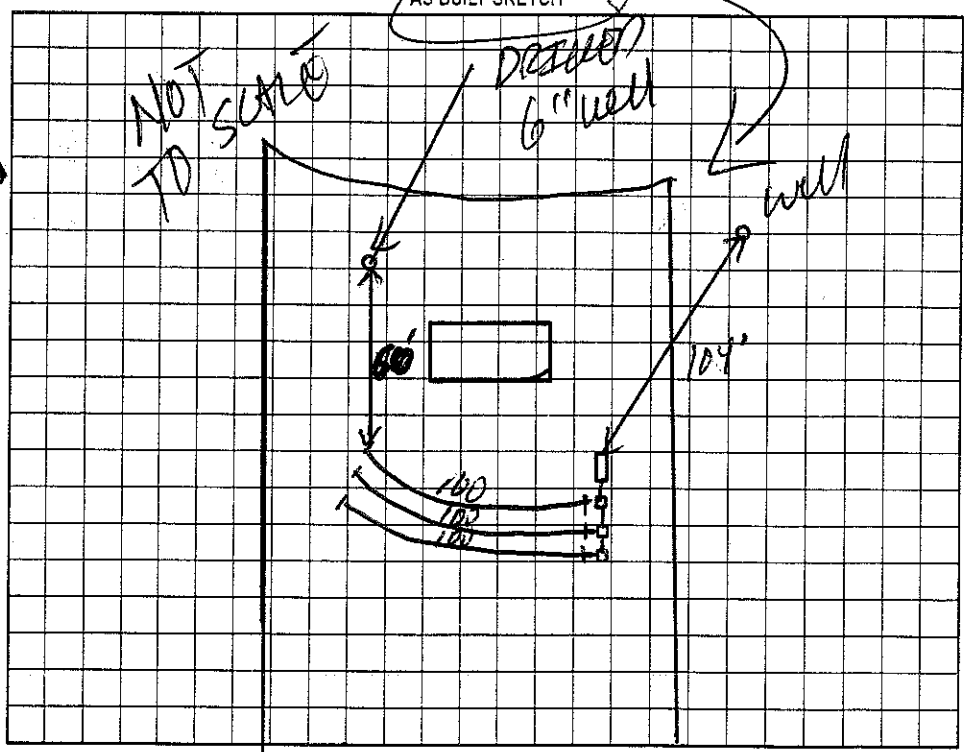

Permit can be suspended or revoked if any false information is supplied toward securing the permit/any unauthorized changes are made to the site/any unauthorized changes are made in the installation of the system. Improvement Permit with plat valid without expiration. Improvement Permit with site plan valid for sixty months. Authorization to Construct is valid for a period equal to that of Improvement Permit – not to exceed sixty months.

Signed: Russell Norris date 8-11-03 Installed by: Steve JORDAN

Improvement Permit by: RS date 3/7/03 Operation Permit by: date 6-22-06

Authorization to Construct by: date 3/15/06 Existing System Inspection by: date

HEALTH DEPT. COPY: WHITE OWNER COPY (FINAL): YELLOW OWNER COPY (INITIAL): PINK