11Am TFrye

This Vicks Permit DATED 5-1-98

IREDELL COUNTY HEALTH DEPARTMENT

STATESVILLE 704-878-5305 MOORESVILLE 704-664-5281

IMPROVEMENT PERMIT / AUTHORIZATION TO CONSTRUCT / OPERATION PERMIT / EXISTING SYSTEM INSPECTION

PERMIT# 71868 PIN# 4772672705 DATE May 26 2000

OWNER OR CONTRACTOR Rick Workman PHONE: Business 528-6644 Home

ADDRESS 120 Hickory Pint Ct Statesville NC 28677

LOCATION I40W ⓓ Old Mt Rd ⓛ Rumple Hill Dr ⓡ Stonefield Dr Last Lot on Right

SUBDIVISION Leppard Springs BLOCK / SECTION II LOT 107 LOT AREA .77 Ac SITE CLASS. PS DESIGN FLOW 480 L.T.A.R. .3

Septic Tank: 1000 Gallons; STB 1012 Date 5 3 00
Pump Tank: Gallons; PT Date
Pump Make: Model Serial No.
Nitrification Field: No Fields 1 Square Feet 1600 SQ Linear Feet 400
No Lines 5 Trench Width 36" Max Trench Bottom Depth 36" Gravel Depth N/A

☒ New System ☐ Repair System Type: I, II, (III) IV, V, VI
System Description: Gravity 25% Reduction
Repair System Description: ~~50%~~ 50% Red. Pump possible
Maintenance Agreement Required: ☐ Yes ☒ No LPP


☒ House/Mod. Home No. Bedrooms 4
☐ Mobile Home No. Bathrooms 2
☐ Business No. Employees
☐ Other
☐ Slab ☒ Crawl Space ☐ Basement w/plumbing ☐ Basement wo/plumbing

Water Supply: ☒ Individual ☐ Public ☐ Community
Well

Comments/Conditions: 67 Chambers OR 40 HBS Sections
5 drop Boxes Locate well 100 FT OR MAX Feasible distance from Septic Field (50 FT min)

Comments/Conditions:

Not To Any Scale INITIAL SITE SKETCH

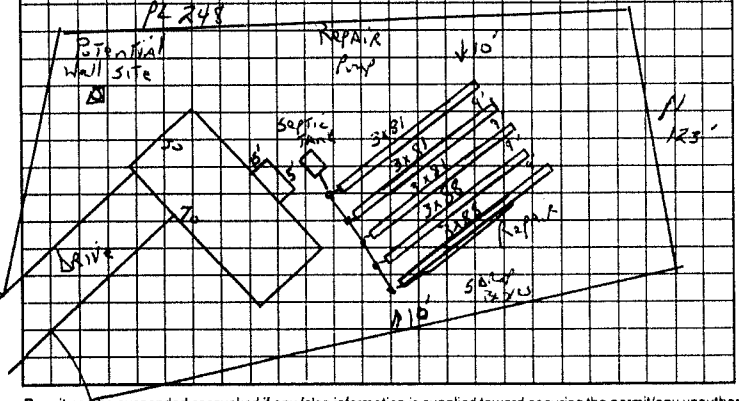

AS BUILT SKETCH

System installed As Designed

Permit can be suspended or revoked if any false information is supplied toward securing the permit/any unauthorized changes are made to the site/any unauthorized changes are made in the installation of the system. Improvement Permit with plat valid without expiration. Improvement Permit with site plan valid for sixty months. Authorization to Construct is valid for a period equal to that of Improvement Permit – not to exceed sixty months.

Signed: Rick Dyer date 6-5-00 Installed by: Tommy Frye

Improvement Permit by: JC Potter date May 26, 2000 Operation Permit by: JC Potter date July 27 2000

Authorization to Construct by: JC Potter date May 26, 2000 Existing System Inspection by: date

HEALTH DEPT. COPY: WHITE OWNER COPY (FINAL): YELLOW OWNER COPY (INITIAL): PINK