IREDELL COUNTY HEALTH DEPARTMENT

STATESVILLE 704-878-5305 MOORESVILLE 704-664-5281

IMPROVEMENT PERMIT / AUTHORIZATION TO CONSTRUCT / OPERATION PERMIT / EXISTING SYSTEM INSPECTION

PERMIT# 12335 PIN# 4772672705 DATE 3-10-98

OWNER OR CONTRACTOR Billy Little PHONE: Business 871 2015 Home

ADDRESS Po Box 1289 Troutman

LOCATION old mtn Rd Turn before KYX Road on Rumple Lane To end

SUBDIVISION Lippard Sp BLOCK / SECTION LOT 90 LOT AREA .87 acres SITE CLASS P5 DESIGN FLOW 360 L.T.A.R. 1.23

Septic Tank: 1000 Gallons: STB 794 Date 7-6-98

Pump Tank: Gallons: PT Date

Pump Make: Model Serial No.

Nitrification Field: No Fields 1 Square Feet 1080 Linear Feet 360

No Lines 3 Trench Width 36" Max Trench Bottom Depth 36" Gravel Depth 12"

☑ New System ☐ Repair System Type: I II III IV V VI

System Description: Conv. Gravity

Repair System Description: " "

Maintenance Agreement Required: ☐ Yes ☑ No

☑ House/Mod. Home No. Bedrooms 3

☐ Mobile Home No. Bathrooms 2

☐ Business No. Employees

☐ Other

☐ Slab ☑ Crawl Space ☐ Basement w/plumbing ☐ Basement wo/plumbing


Water Supply: ☑ Individual ☐ Public ☐ Community

Comments:/Conditions: 125'

Comments:/Conditions:

Note: Tank Turned parallel w/ house

INITIAL SITE SKETCH

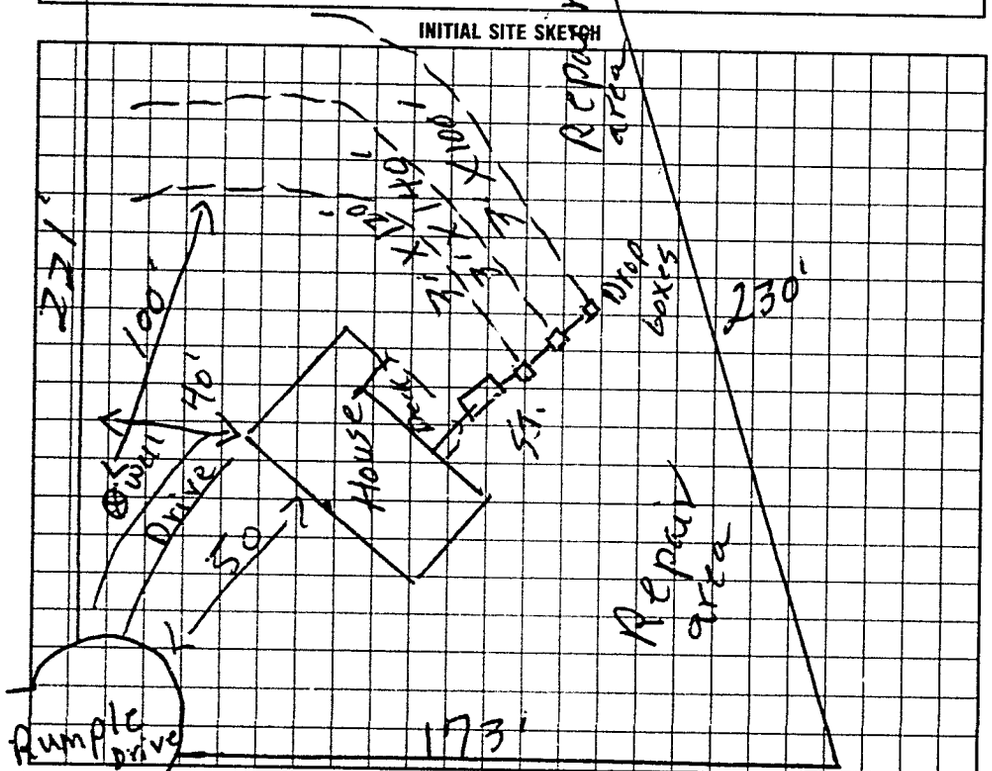

AS BUILT SKETCH

Installed as shown

I understand that this permit can be suspended or revoked if any false information is supplied toward securing the permit/any unauthorized changes are made to the site/any unauthorized changes are made in the installation of the system. Improvement Permit with plat valid without expiration. Improvement Permit with site plan valid for sixty months. Authorization to Construct is valid for a period equal to that of Improvement Permit – not to exceed sixty months.

Signed: _____ date _____

Improvement Permit by: P. C. Moore date 3-10-98

Authorization to Construct by: P. C. Moore date 3-10-98

Installed by: W. Dobson

Operation Permit by: [illegible] RS date 8-25-98

Existing System Inspection by: _____ date _____

HEALTH DEPT. COPY: WHITE INSPECTION COPY (FINAL): GREEN OWNER COPY (FINAL): YELLOW INSPECTION COPY (INITIAL): PINK OWNER COPY (INITIAL) GOLD